IREDELL COUNTY HEALTH DEPARTMENT

STATESVILLE 704-878-5305 MOORESVILLE 704-664-5281 $130

IMPROVEMENT PERMIT / AUTHORIZATION TO CONSTRUCT / OPERATION PERMIT / EXISTING SYSTEM INSPECTION

PERMIT# 11928 PIN# 4638-88-6024 4638-88-5180 DATE

OWNER OR CONTRACTOR Matthew S. Cheney PHONE: Business Home 704 575 7841

ADDRESS 4105 North Cross Dr Charlotte NC 28277

LOCATION Perth, TR Erne, TL Harbor Landing, At End on Rt

SUBDIVISION Harbor Landing BLOCK / SECTION 4 LOT 298 LOT AREA 0.955AC SITE CLASS PS DESIGN FLOW 480 L.T.A.R. 0.3

Septic Tank: 1000 Gallons; STB 312 Date 5/25/04
Pump Tank: 1000 Gallons; PT 283 Date 5/25/04
Pump Make: Zoeller Model N98-B Serial No.
Nitrification Field: No Fields 1 Square Feet 1200 Linear Feet 400
No Lines 4@100 Trench Width 36" Max Trench Bottom Depth 36" Gravel Depth

☒ New System ☐ Repair System Type: I, II, (III), IV, V, VI
System Description: PM 25% Reduction
Repair System Description: LP Panel Block
Maintenance Agreement Required: ☐ Yes ☒ No

☒ House/Mod. Home No. Bedrooms 4
☐ Mobile Home No. Bathrooms 3
☐ Business No. Employees
☐ Other

☐ Slab ☒ Crawl Space ☐ Basement w/plumbing ☐ Basement wo/plumbing


Water Supply: ☐ Individual ☐ Public ☒ Community

Comments:/Conditions:

1" = 50'

Proposed Deck & Stairs

INITIAL SITE SKETCH

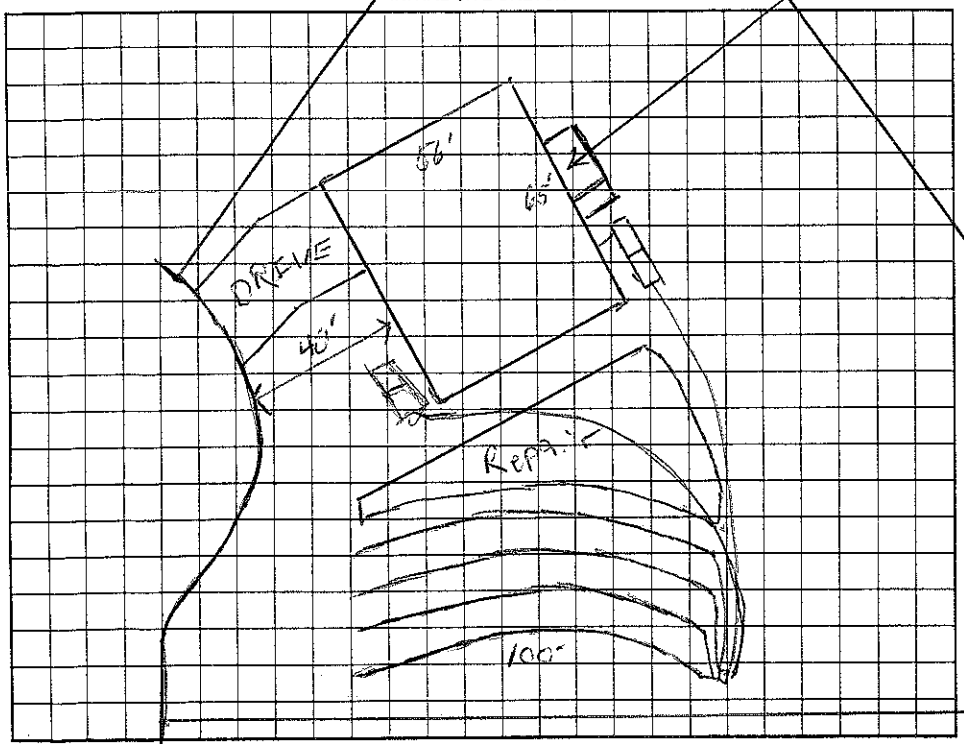

Comments:/Conditions:

AS BUILT SKETCH

The proposed / existing Deck & Stairs addition does not appear to impact the existing septic system.

**NOTE:

Mary Melville R.S.

Date: 6-11-13

ICHD-Environmental Health Division

Permit can be suspended or revoked if any false information is supplied toward securing the permit/any unauthorized changes are made to the site/any unauthorized changes are made in the installation of the system. Improvement Permit with plat valid without expiration. Improvement Permit with site plan valid for sixty months. Authorization to Construct is valid for a period equal to that of Improvement Permit – not to exceed sixty months.

Signed: Guy C Cheney date 3/16/04 Installed by: Robert Laney

Improvement Permit by: RS date 5/15/04 Operation Permit by: RS date 7/21/04

Authorization to Construct by: RS date 5/15/04 Existing System Inspection by: date

HEALTH DEPT. COPY: WHITE OWNER COPY (FINAL): YELLOW OWNER COPY (INITIAL): PINK