IREDELL COUNTY HEALTH DEPARTMENT

STATESVILLE 704-878-5305 MOORESVILLE 704-664-5281

IMPROVEMENT PERMIT / AUTHORIZATION TO CONSTRUCT / OPERATION PERMIT / EXISTING SYSTEM INSPECTION

PERMIT# 072720 PIN# ~~4639734550~~ 4638 88 6901 DATE Nov. 24 '98

OWNER OR CONTRACTOR Stumpy Creek LLC PHONE: Business Home

ADDRESS 614 N. Main Statesville 28144

LOCATION 1500 TR Perth Rd TR Harbor Landing DR. Bear left on left

SUBDIVISION ~~Harbor Landing~~ BLOCK / SECTION 4 LOT 71 LOT AREA 38,966 ~~ft²~~ SITE CLASS. 5 DESIGN FLOW ~~480~~ 360 gpd L.T.A.R. .3

Septic Tank: 1000 Gallons; STB 774 Date 4/11/94

Pump Tank: Gallons; PT Date

Pump Make: Model "W" Serial No.

Nitrification Field: No Fields 1 Square Feet 1200 Linear Feet ~~400~~ 300

No Lines 5@80 Trench Width 36" Max Trench Bottom Depth 24"

☒ New System ☐ Repair System Type: I, II, III, IV, V, VI

System Description: Gravity 25% Reduction Incentive

Repair System Description: Pumped 25% Red Incentive

Maintenance Agreement Required: ☐ Yes ☒ No

Gravel Depth NA

☒ House/Mod. Home No. Bedrooms 4

☐ Mobile Home No. Bathrooms 3

☐ Business No. Employees

☐ Other

☐ Slab ☒ Crawl Space ☐ Basement w/plumbing ☐ Basement wo/plumbing


Water Supply: ☐ Individual ☒ Public ☐ Community

Comments:/Conditions: XOVE inspection port per LATERAL
Remove any old drums, terraces.


Comments:/Conditions:
As built

1"=60'

INITIAL SITE SKETCH

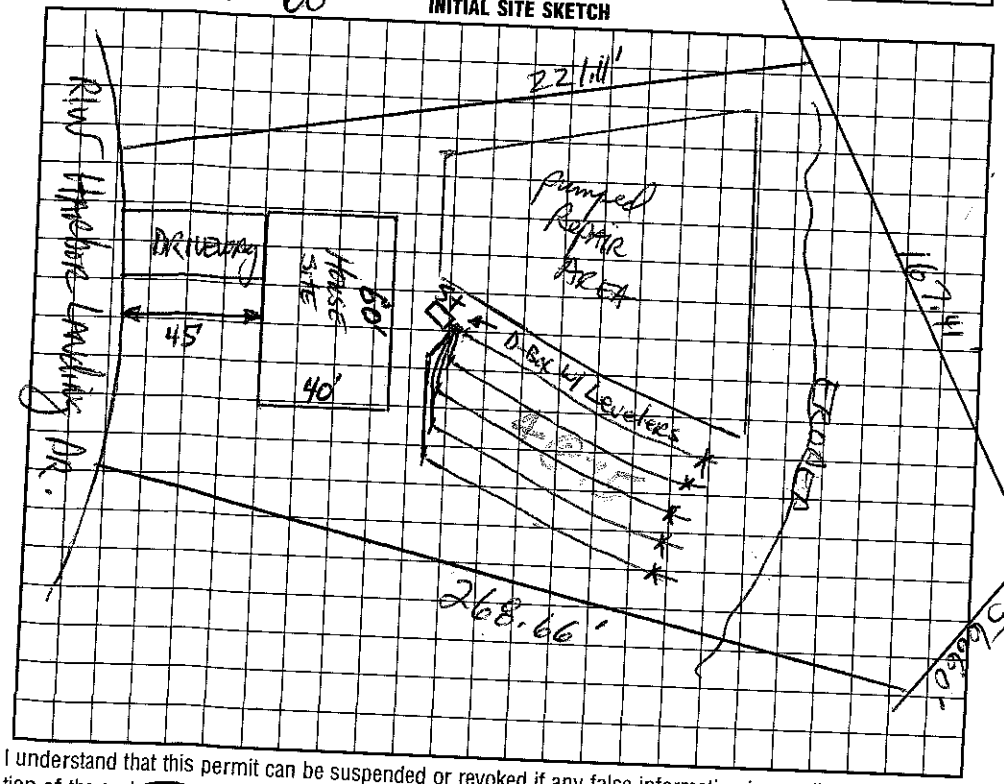

AS BUILT SKETCH

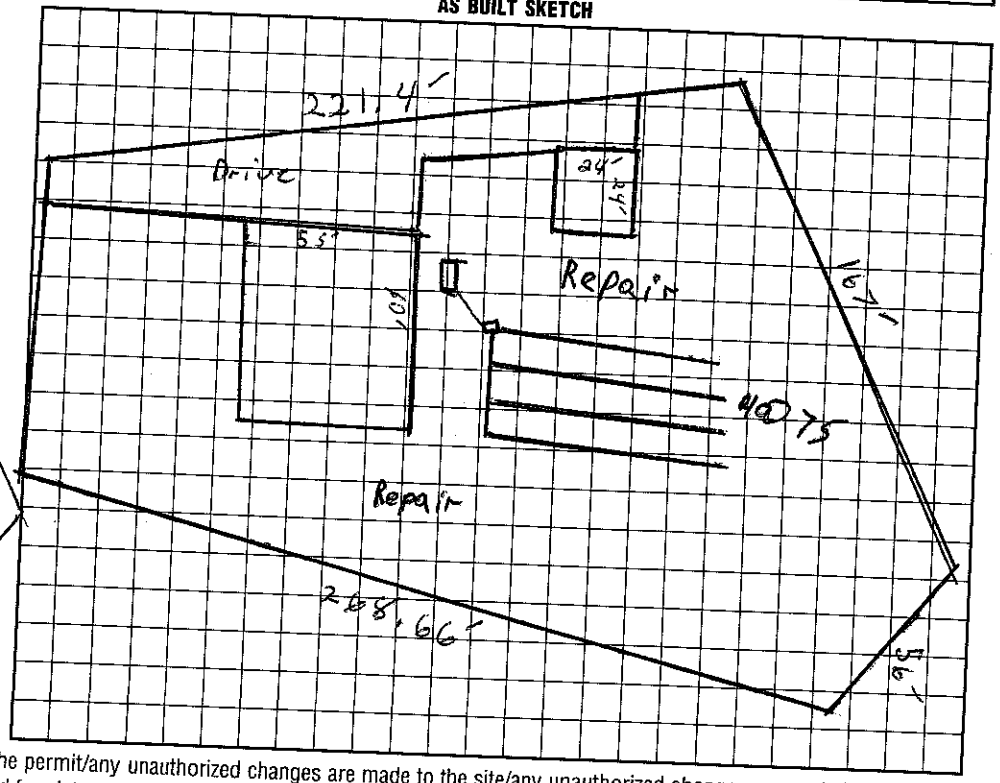

I understand that this permit can be suspended or revoked if any false information is supplied toward securing the permit/any unauthorized changes are made to the site/any unauthorized changes are made in the installation of the system. Improvement Permit with plat valid without expiration. Improvement Permit with site plan valid for sixty months. Authorization to Construct is valid for a period equal to that of Improvement Permit – not to exceed sixty months.

Signed:

Improvement Permit by: date 11/25/98

Authorization to Construct by: date 11-21-98

Installed by: date 12/16/98

Operation Permit by: date 5/15/99

Existing System Inspection by: date

HEALTH DEPT. COPY: WHITE INSPECTION COPY (FINAL): GREEN OWNER COPY (FINAL): YELLOW INSPECTION COPY (INITIAL): PINK OWNER COPY (INITIAL): GOLD