IREDELL COUNTY HEALTH DEPARTMENT

Statesville Office (704) 878-5305 Mooresville Office (704) 660-3625 PERMIT # 072769

IMPROVEMENT PERMIT / AUTHORIZATION TO CONSTRUCT / OPERATION PERMIT / EXISTING SYSTEM

PIN # 4638-88-7532

APPLICANT: Craig Greer APPLICANT ADDRESS: 267 Harbor Landing Dr Mooresville NC 28117

SITE ADDRESS: 267 Harbor Landing Dr PHONE: 704-662-8360 ALT. PHONE: 704-914-8038

SITE DIRECTIONS: Hwy 150 W, LR on Perth Rd, Cross bridge, TR on Erne Dr, TL on Harbor Landing Dr, House on L before End

SUBDIVISION: Harbor Landing SECTION: 4 LOT# 74 LOT AREA: 0.53 ac DESIGN FLOW: 360 L.T.A.R.:

Septic Tank EXISTING (1000 gal) STB Date
Pump Tank (gal) PT Date
Pump Make Model Serial #
Nitrification Fields # Lines Linear Ft:
Trench Width Max. Trench Bottom Depth Gravel Depth N/A


☐ New System ☑ Repair ☐ Expansion System Type: I II III IV V VI
System Description: EXISTING E-2 Flow
Repair System Description: Pump 25% Reduction
Maintenance Agreement Required: ☐ YES ☑ NO
☑ GRAVITY ☐ PRESSURE

☑ Residence No. Bedrooms 3
☐ Business No. Persons 3
☐ Other No. Employees
☐ Slab ☑ Crawl Space
☐ Basement w/plumbing ☐ Basement w/o plumbing

Water Supply: ☐ Private ☐ Public ☑ Community

Comments / Conditions: ★ Replace D-Box that is damaged with New D-Box

INITIAL SITE SKETCH

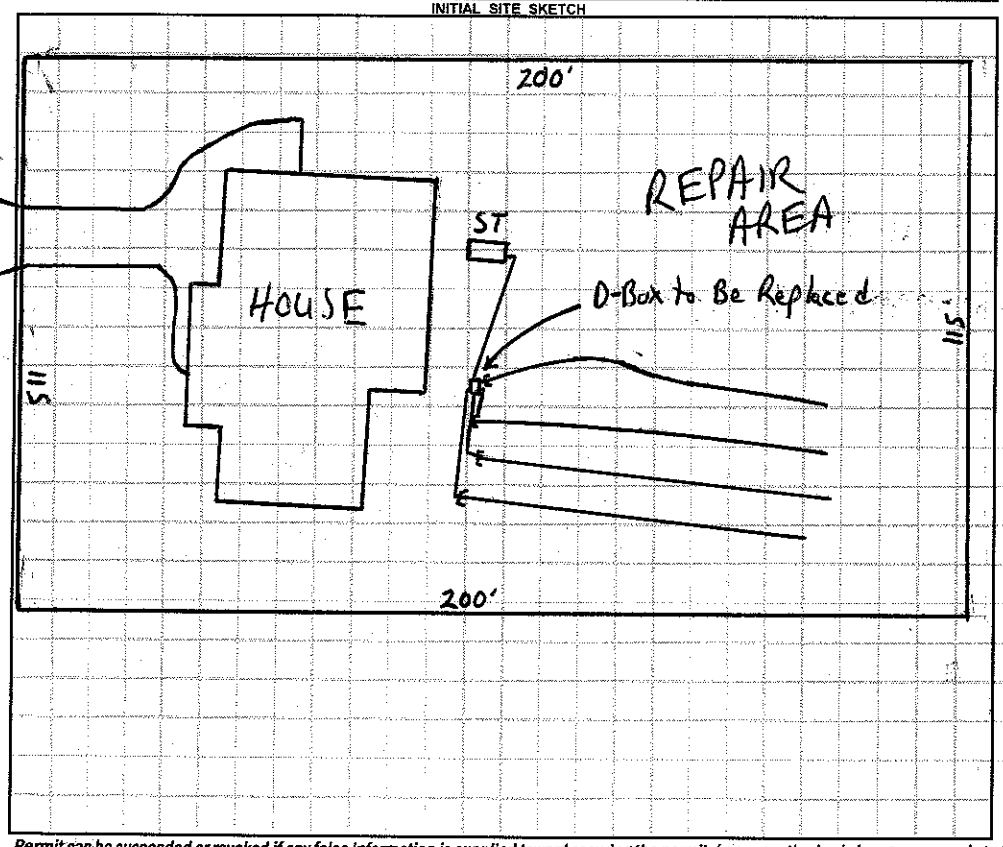

AS BUILT SKETCH

PLASTIC D BOX INSTALLED

Permit can be suspended or revoked if any false information is supplied toward securing the permit / any unauthorized changes are made to the site / any unauthorized changes are made in the installation of the system. **CONTACT A LOCATOR SERVICE PRIOR TO ANY EXCAVATION**

☐ **IMPROVEMENT PERMIT** *with plat valid without expiration.* ☑ **IMPROVEMENT PERMIT** *with site plan valid for 60 mos.* ☑ **AUTHORIZATION TO CONSTRUCT** *valid for period equal to IMPROVEMENT PERMIT--not to exceed 60 mo.*

Owner / Applicant Signature: Date: 1/2/14 Installed by: STANLEY

IMPROVEMENT PERMIT by: Date: 1-2-14 OPERATION PERMIT by: Date: 1-13-14

AUTHORIZATION TO CONSTRUCT by: Date: 1-2-14 Existing System Inspected by: Date:

Health Dept. Copy - WHITE Applicant (Final Approval) - YELLOW Applicant (Conditional Approval) - PINK