IREDELL COUNTY HEALTH DEPARTMENT

STATESVILLE 704-878-5305 MOORESVILLE 704-664-5281

IMPROVEMENT PERMIT / AUTHORIZATION TO CONSTRUCT / OPERATION PERMIT / EXISTING SYSTEM INSPECTION

PERMIT# 072768 PIN# ~~4639734550~~ 4638-88-7532 DATE Nov. 21, '98

OWNER OR CONTRACTOR Stumpy Creek LLC PHONE: Business Home

ADDRESS 619 W Main Salisbury 28144

LOCATION 150 W. TR Perth Rd TR Harbor Landing Dr. Bear left on left

SUBDIVISION Harbor Landing BLOCK / SECTION 4 LOT 14 LOT AREA 23,000sf± SITE CLASS. PS DESIGN FLOW 360gpd L.T.A.R. .3

Septic Tank: 1000 Gallons; STB Date 10/26/98
Pump Tank: Gallons; PT Date
Pump Make: Model Serial No.
Nitrification Field: No Fields 1 Square Feet 900 Linear Feet 300
No Lines 4@75' Trench Width 36" Max Trench Bottom Depth 30" Gravel Depth N/A

☑ New System ☐ Repair System Type: I, II, III, IV, V, VI
System Description: GRAVITY 25% Reduction / INNOVATIVE
Repair System Description: pumped-25% Red / ~~INNOVATIVE~~
Maintenance Agreement Required: ☐ Yes ☑ No

☑ House/Mod. Home No. Bedrooms 3
☐ Mobile Home No. Bathrooms 3
☐ Business No. Employees
☐ Other
☐ Slab ☑ Crawl Space ☐ Basement w/plumbing ☐ Basement wo/plumbing


Water Supply:
☐ Individual
☑ ~~Public~~
☐ ~~Community~~

Comments:/Conditions: * ONE INSPECTION PORT PER LATERAL.
Remove any old burns, terraces.

Comments:/Conditions:

1"=60'

INITIAL SITE SKETCH

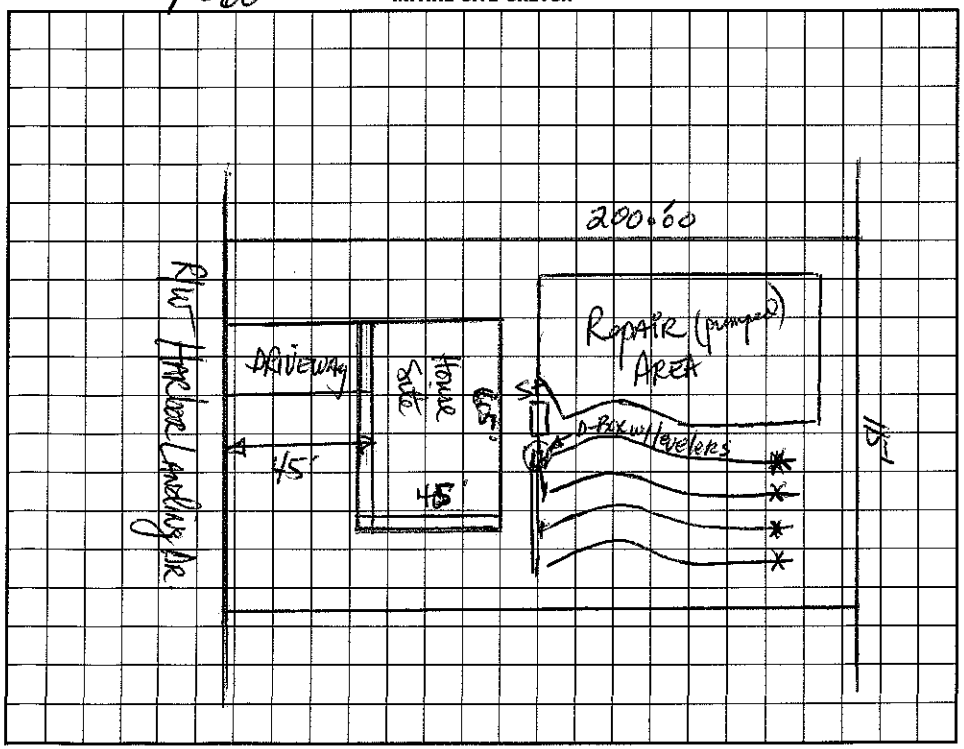

AS BUILT SKETCH

I understand that this permit can be suspended or revoked if any false information is supplied toward securing the permit/any unauthorized changes are made to the site/any unauthorized changes are made in the installation of the system. Improvement Permit with plat valid without expiration. Improvement Permit with site plan valid for sixty months. Authorization to Construct is valid for a period equal to that of Improvement Permit – not to exceed sixty months.

Signed: date 11/25/98 Installed by: R+H Inc.

Improvement Permit by: date 11-21-98 Operation Permit by: Wesley Sparks RS. date 4/17/00

Authorization to Construct by: date 12/11/98 Existing System Inspection by: date

HEALTH DEPT. COPY: WHITE INSPECTION COPY (FINAL): GREEN OWNER COPY (FINAL): YELLOW INSPECTION COPY (INITIAL): PINK OWNER COPY (INITIAL): GOLD