IREDELL COUNTY HEALTH DEPARTMENT

STATESVILLE 878-5305 50.00 7-19-00 DT MOORESVILLE 704-664-5281

IMPROVEMENT PERMIT / AUTHORIZATION TO CONSTRUCT / OPERATION PERMIT / EXISTING SYSTEM INSPECTION

PERMIT# 072767 PIN# ~~4639734550~~ 7638-88-7603

OWNER OR CONTRACTOR Stumpy Creek LLC / Karen Frederick PHONE: Business 306-4077 (Ray) DATE 7/14/2000

ADDRESS 614 N. Main Salisbury 28144 9929 Elsenham Ln Charlotte 28269 Home 549-8514

LOCATION 150 W TR Perth TR Harbor Landing Rear left on left

SUBDIVISION Harbor Landing BLOCK / SECTION 4 LOT 73 LOT AREA 25,826sf SITE CLASS. PS DESIGN FLOW 360gpd L.T.A.R. .3

Septic Tank: 1000 Gallons; STB 794 Date 7-16-00

Pump Tank: ____ Gallons; PT ____ Date ____

Pump Make: ____ Model ____ Serial No. ____

Nitrification Field: No Fields 1 Square Feet 900 Linear Feet 300

No Lines 3 at 100 Trench Width 36" Max Trench Bottom Depth 30" Gravel Depth N/A

☒ New System ☐ Repair System Type: I, II, III, IV, V, VI

System Description: Gravity - 25% Reduction

Repair System Description Grav/Pump - Powell Innovative

Maintenance Agreement Required ☐ Yes ☒ No

☒ House/Mod. Home No. Bedrooms 3

☐ Mobile Home No. Bathrooms 3

☐ Business No. Employees ____

☐ Other ____


☐ Slab ☒ Crawl Space ☐ Basement w/plumbing ☐ Basement wo/plumbing

Water Supply: ☐ Individual ☒ Public ☐ Community


Comments/Conditions: Keep Septic System 10' From PL & 5' From House.

Comments/Conditions: ☆ Keep Septic System 15' from Future Pool location ☆ Water line must be at least 10' from Septic System.

INITIAL SITE SKETCH Scale 1:60'

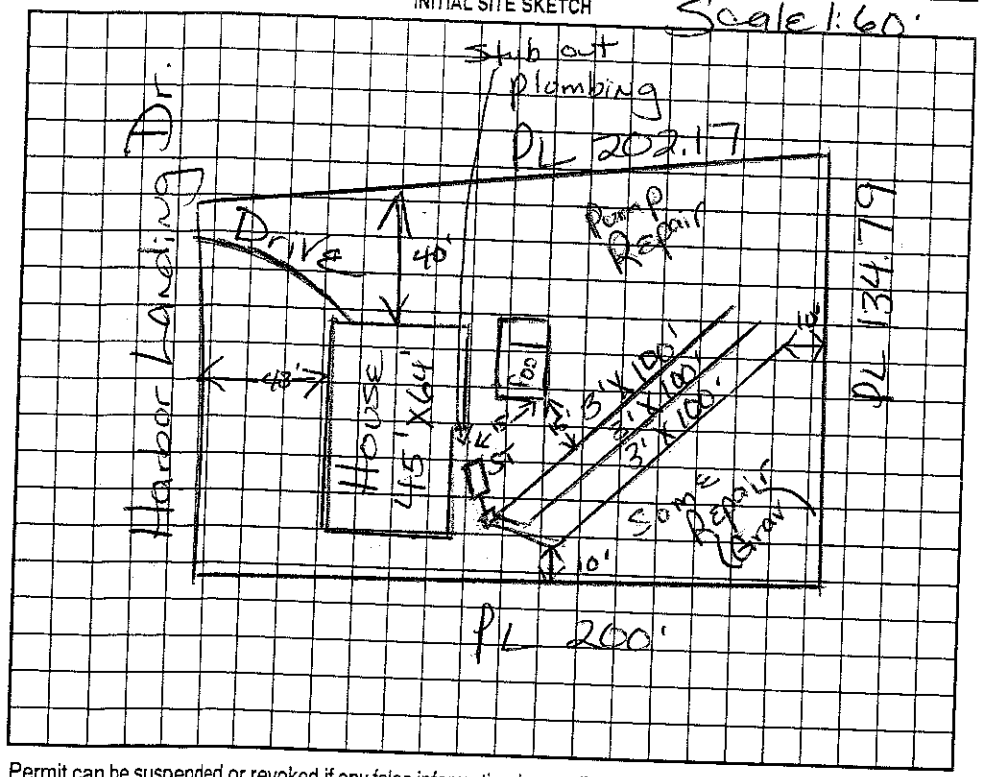

AS BUILT SKETCH

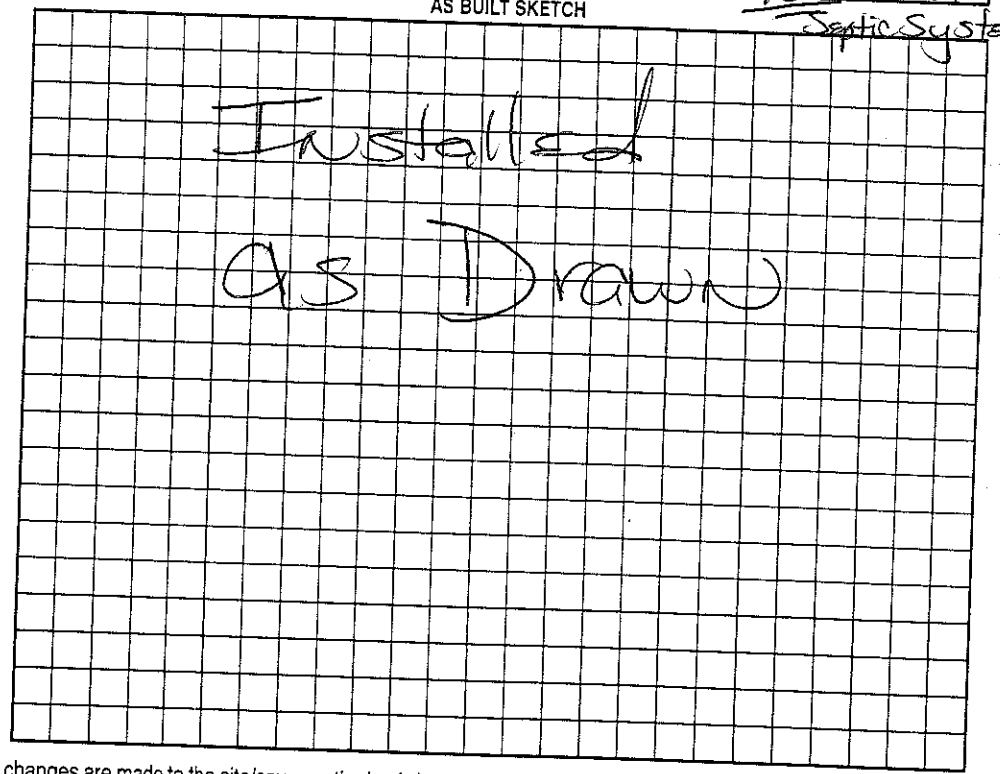

Permit can be suspended or revoked if any false information is supplied toward securing the permit/any unauthorized changes are made to the site/any unauthorized changes are made in the installation of the system. Improvement Permit with plat valid without expiration. Improvement Permit with site plan valid for sixty months. Authorization to Construct is valid for a period equal to that of Improvement Permit – not to exceed sixty months.

Signed: Karen Frederick date 7/19/00 Installed by: Ralph Lee

Improvement Permit by: Maintained Dotson RS date 7/14/2000 Operation Permit by: Maintained Dotson RS date 8/29/00

Authorization to Construct by: Maintained Dotson RS date 7/14/2000 Existing System Inspection by: ____ date ____

HEALTH DEPT. COPY: WHITE OWNER COPY (FINAL): YELLOW OWNER COPY (INITIAL): PINK