IREDELL COUNTY HEALTH DEPARTMENT

STATESVILLE 704-878-5305 MOORESVILLE 704-664-5281

IMPROVEMENT PERMIT / CERTIFICATE OF COMPLETION / OPERATION PERMIT / EXISTING SYSTEM INSPECTION

PROPERTY DESCRIPTION NO. 20540 DATE April 23, 195 TAX MAP NO. part of 25A51 4638 89 3942 Watershed: ☑ Yes ☐ No AWS IC

OWNER OR CONTRACTOR Kwom Financial Services PHONE: Business 664-3671 Home

ADDRESS 19 Yacht Cove Rd, Mooresville

LOCATION Perth Rd N. TR Cornelius Rd. TR Creek View Lane 3rd lot on left

SUBDIVISION Mills Pond BLOCK / SECTION 2 LOT 91 LOT AREA 1.97AC SITE CLASS. AS DESIGN FLOW 360 gpd L.T.A.R. .3

Septic Tank: 1000 Gallons; STB 825 Date 7/3/96
Pump Tank: Gallons; PT 47 Date 7/15/96
Pump Make: Model Serial No.
Nitrification Field: No Fields 1 Square Feet 1200 Linear Feet 400
No Lines 3 Trench Width 36" Max Trench Bottom Depth 36" Gravel Depth 12"

☑ New System ☐ Repair System Type: I, II, III, IV, V, VI
System Description: pumped conventional
Repair System Description: same
Maintenance Agreement Required: ☐ Yes ☑ No

☑ House/Mod. Home No. Bedrooms 3
☐ Mobile Home No. Bathrooms 2
☐ Business No. Employees
☐ Other

☐ Slab ☑ Crawl Space ☐ Basement w/plumbing ☐ Basement wo/plumbing


Water Supply: ☑ Individual ☐ Community ☐ Public

Comments: laterals to follow contour.


Comments: READY TO ISSUE 9/23/95 AWS

1"=50'

INITIAL SITE SKETCH

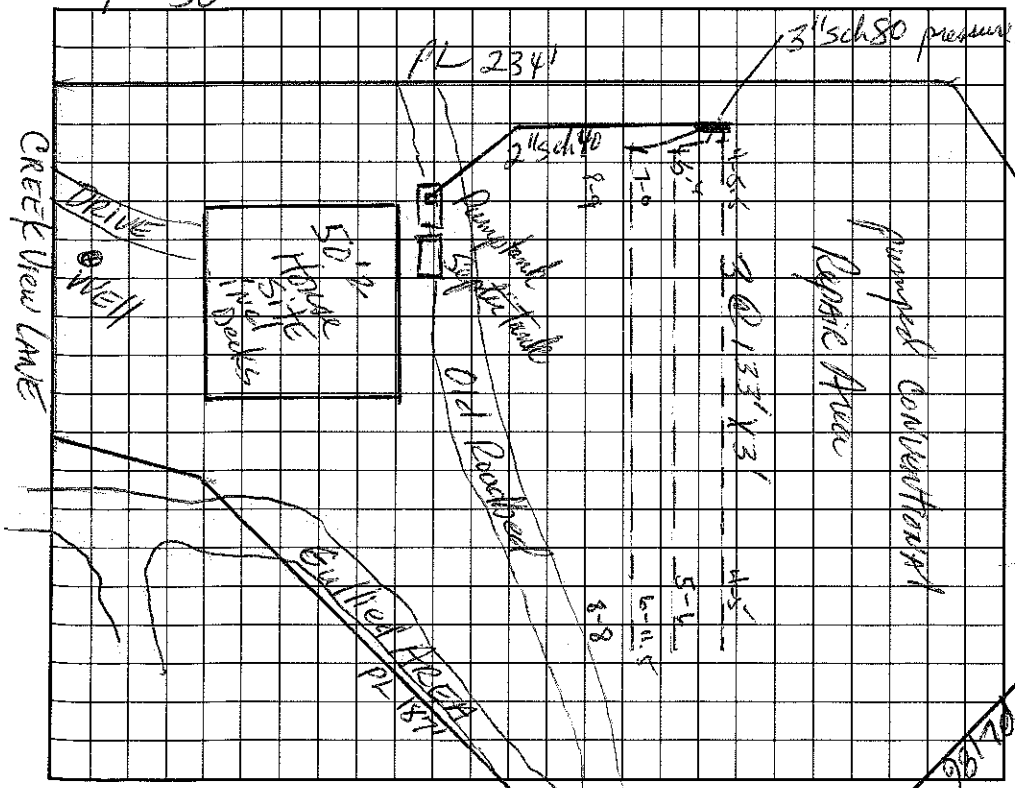

AS BUILT SKETCH

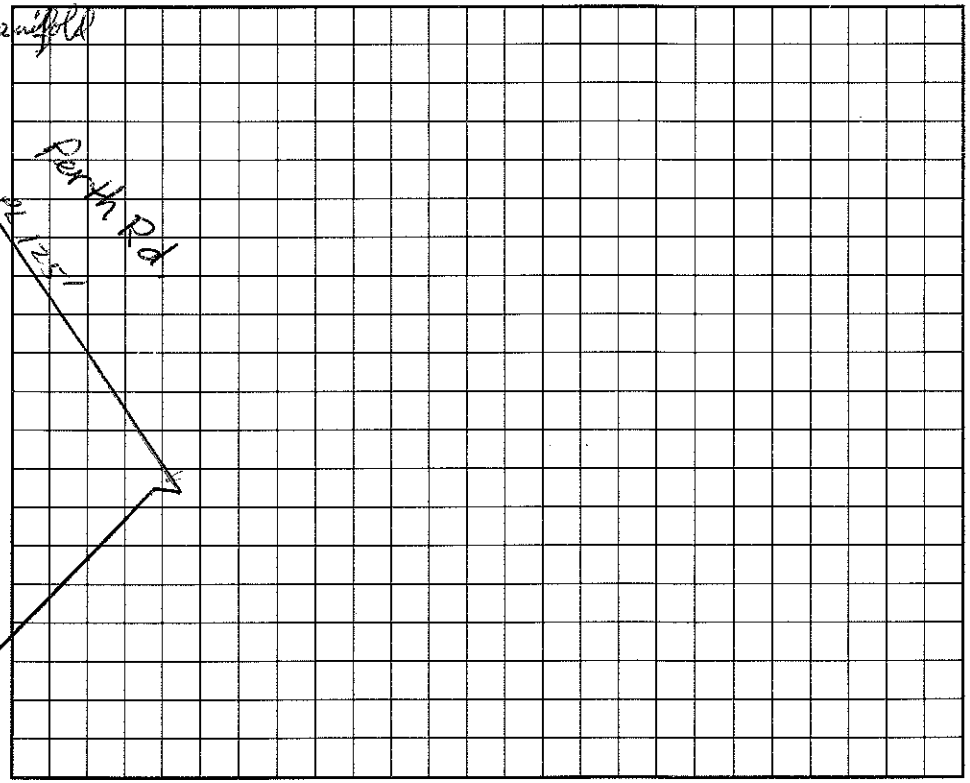

I understand that this permit can be suspended or revoked if any false information is supplied toward securing the permit/any unauthorized changes are made to the site/any unauthorized changes are made in the installation of the system. Improvement Permit is valid for 60 months from date of issuance.

Signed: Wesley Sparks RS 9/23/95

Improvement Permit by: Dave Hamm RS date 4/23/95

Existing System Inspection by: date

Installed by: Rowan Septic Tank

Certificate of Completion by: date

Operation Permit by: Wesley Sparks RS date 9/27/96

HEALTH DEPT. COPY: WHITE INSPECTION COPY (FINAL): GREEN OWNER COPY (FINAL): YELLOW INSPECTION COPY (INITIAL): PINK OWNER COPY (INITIAL): GOLD