IREDELL COUNTY HEALTH DEPARTMENT

STATESVILLE 704-878-5305 MOORESVILLE 704-664-5281

IMPROVEMENT PERMIT / CERTIFICATE OF COMPLETION / OPERATION PERMIT / EXISTING SYSTEM INSPECTION

PROPERTY DESCRIPTION NO. 20297 DATE April 5, 95 TAX MAP NO. part of 2SA51 Watershed: ☑ Yes ☐ No WSIV

OWNER OR CONTRACTOR Krom Financial Services PHONE: Business 664 [illegible]3671 Home 4638-89-4613

ADDRESS 19 Yacht Cove Rd Mooresville NC

LOCATION Pettit Rd N. to Cornelius Rd Approx 200' on left

SUBDIVISION Mills Forest Hills BLOCK / SECTION ____ LOT 32 LOT AREA 1.4Ac SITE CLASS. RS DESIGN FLOW 360 gpd L.T.A.R. .3

Septic Tank: 1000 Poly Gallons; STB 925 Date 10/11/96

Pump Tank: ____ Gallons; PT ____ Date ____

Pump Make: ____ Model ____ Serial No. ____

Nitrification Field: No Fields 1 Square Feet 1200 Linear Feet 400

No Lines 4 Trench Width 36" Max Trench Bottom Depth 36" Gravel Depth 12"

☑ New System ☐ Repair System Type: I, ☑ II, III, IV, V, VI

System Description: gravity conventional

Repair System Description: √ same

Maintenance Agreement Required: ☐ Yes ☒ No

☐ Slab ☑ Crawl Space ☐ Basement w/plumbing ☐ Basement wo/plumbing

☑ House/Mod. Home No. Bedrooms 3

☐ Mobile Home No. Bathrooms 2

☐ Business No. Employees ____

☐ Other ____

Water Supply: ☑ Individual ☐ Community ☐ Public

Comments:


5

74


Comments: [redacted] RWS 9/23/95 CHANGED TO TYPE III CHAMBERED.

1" = 100'

INITIAL SITE SKETCH

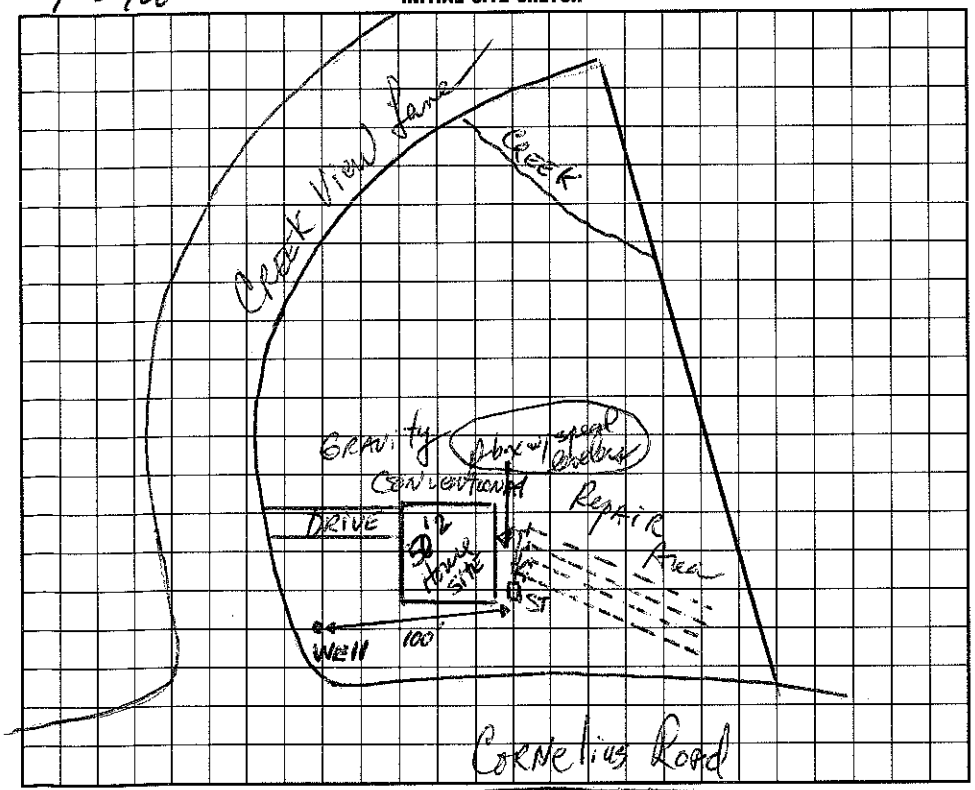

AS BUILT SKETCH

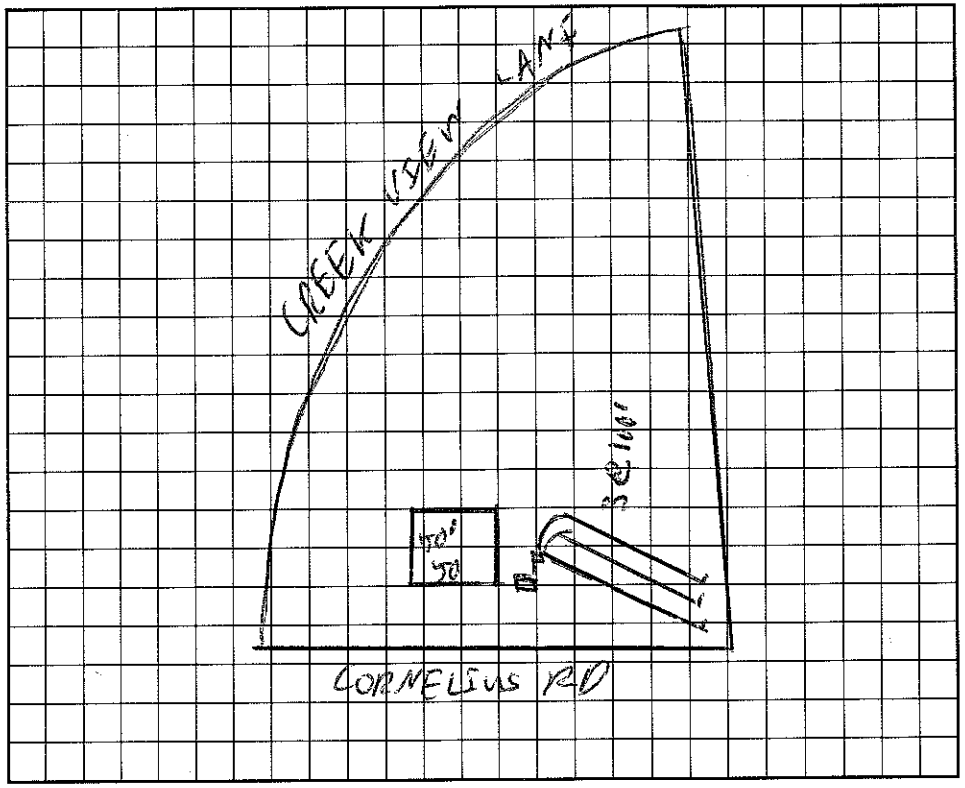

I understand that this permit can be suspended or revoked if any false information is supplied toward securing the permit/any unauthorized changes are made to the site/any unauthorized changes are made in the installation of the system. Improvement Permit is valid for 60 months from date of issuance.

Signed: [signature] Wesley Sparks RS. 9/23/95

Improvement Permit by: David R Hanson, RS date 4/5/95

Existing System Inspection by: ____ date ____

Installed by: ROWAN SEPTIC

Certificate of Completion by: ____ date ____

Operation Permit by: C. Ruby Teem EHS date 9/23/96

HEALTH DEPT. COPY: WHITE INSPECTION COPY (FINAL): GREEN OWNER COPY (FINAL): YELLOW INSPECTION COPY (INITIAL): PINK OWNER COPY (INITIAL): GOLD