IREDELL COUNTY HEALTH DEPARTMENT

STATESVILLE 704-878-5305 MOORESVILLE 704-664-5281

IMPROVEMENT PERMIT / CERTIFICATE OF COMPLETION / OPERATION PERMIT / EXISTING SYSTEM INSPECTION

PROPERTY DESCRIPTION NO. 20541 DATE April 23, '95 TAX MAP NO. part of 2SA51 4638894986 Watershed: ☑ Yes ☐ No

OWNER OR CONTRACTOR Krom Financial Services PHONE: Business 664-3671 Home WSIL

ADDRESS 19 Yacht Cove Rd. ; Mooresville

LOCATION North Rd N. TR Cornelius Rd. TL Creek View Lane 4th lot on left

SUBDIVISION Mills Pond BLOCK / SECTION 2 LOT 90 LOT AREA .63 Ac SITE CLASS. PS DESIGN FLOW 360 gpd L.T.A.R. .3

Septic Tank: 1000 Gallons; STB 825 Date 11/20/96

Pump Tank: 1000 Gallons; PT 1087 Date 11/18/96

Pump Make: ZOELLER Model 163 Serial No.

Nitrification Field: No Fields 1 Square Feet 900 Linear Feet 300

No Lines 3 Trench Width 36" Max Trench Bottom Depth 36" Gravel Depth N/A

☑ New System ☐ Repair System Type: I, II, III, IV, V, VI

System Description: pump/pm/IN filtrator LPPPBPS

Repair System Description:

Maintenance Agreement Required: ☐ Yes ☑ No

☑ House/Mod. Home No. Bedrooms 3

☐ Mobile Home No. Bathrooms 2

☐ Business No. Employees

☐ Other

☐ Slab ☑ Crawl Space ☐ Basement w/plumbing ☐ Basement wo/plumbing

Water Supply: ☑ Individual ☐ Community ☐ Public


Comments: laterals to follow contour

S11 - T2 - S6 - 44


Comments: [redacted] WELL NOT LOCATED AT TIME OF INSPECTION. LINES, TANKS, PRESSURE CHECKED 2/25/97.

1"=50'

INITIAL SITE SKETCH

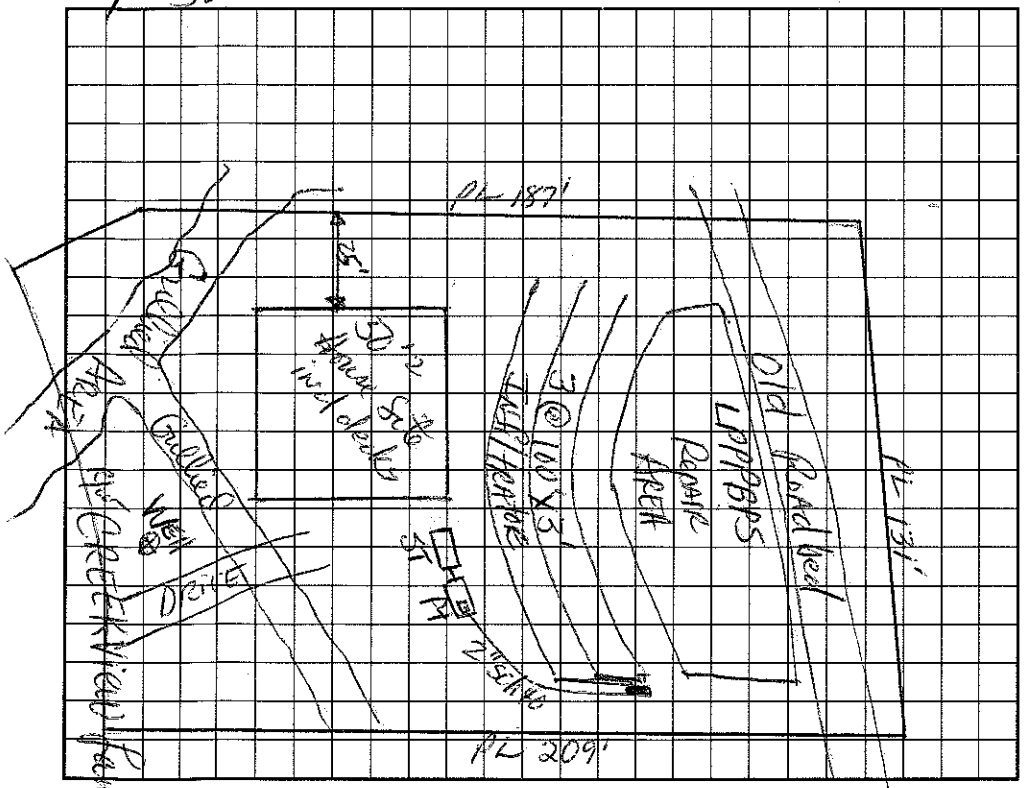

AS BUILT SKETCH

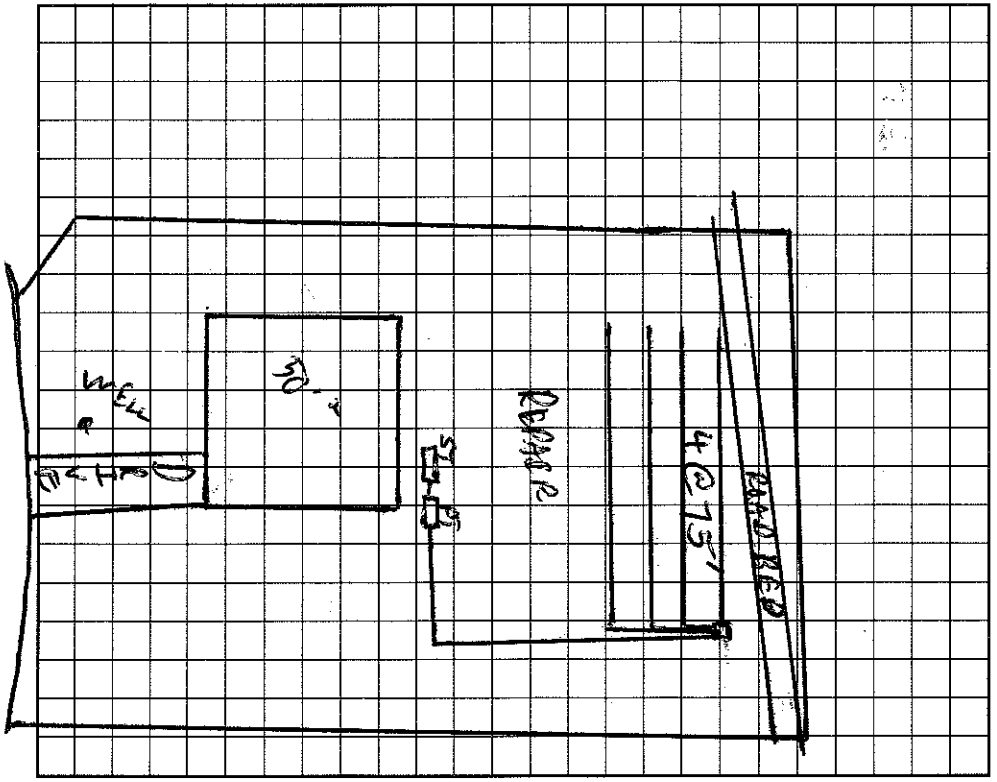

I understand that this permit can be suspended or revoked if any false information is supplied toward securing the permit/any unauthorized changes are made to the site/any unauthorized changes are made in the installation of the system. Improvement Permit is valid for 60 months from date of issuance.

Signed: Wesley Sparks 9/23/95

Improvement Permit by: Jack R. Hinson RS date 4/23/95

Existing System Inspection by: date

Installed by: ROWAN SEPTIC

Certificate of Completion by: Wesley Sparks RS. date 3/24/97

Operation Permit by: Wesley Sparks RS. date 3/24/97

HEALTH DEPT. COPY: WHITE INSPECTION COPY (FINAL): GREEN OWNER COPY (FINAL): YELLOW INSPECTION COPY (INITIAL): PINK OWNER COPY (INITIAL): GOLD