IREDELL COUNTY HEALTH DEPARTMENT

STATESVILLE 704-878-5305 MOORESVILLE 704-664-5281

IMPROVEMENT PERMIT / CERTIFICATE OF COMPLETION / OPERATION PERMIT / EXISTING SYSTEM INSPECTION

PROPERTY DESCRIPTION NO. 2054z DATE April 23, 95 TAX MAP NO. part of 2SA57 Watershed: ☑ Yes ☐ No

OWNER OR CONTRACTOR Knox Financial Services PHONE: Business 664-3671 Home WSIV

ADDRESS 19 Yacht Cove Rd Mooresville 4638-89-6912

LOCATION Perth Rd. N. TR Cornelius Rd. TL Creek View Lane 5th lot on left

SUBDIVISION Mills Pond BLOCK / SECTION LOT 89 LOT AREA .65 ac SITE CLASS. PS pm 1956 DESIGN FLOW 360 gpd L.T.A.R. .3

Septic Tank: 1000 Gallons; STB 925 Date 7/9/96

Pump Tank: Gallons; PT Date

Pump Make: Model Serial No.

Nitrification Field; No Fields 1 Square Feet 1200 Linear Feet 400

No Lines 4 Trench Width 36" Max Trench Bottom Depth 36" Gravel Depth 12"

☑ New System ☐ Repair System Type: I, (II) III, IV, V, VI

System Description: gravity conventional

Repair System Description: Jet w/ Infiltrator

Maintenance Agreement Required: ☐ Yes ☑ No

☑ House/Mod. Home ☐ Mobile Home ☐ Business ☐ Other

No. Bedrooms 3 No. Bathrooms 2 No. Employees

Water Supply: ☐ Individual ☐ Community ☐ Public


☑ Slab ☐ Crawl Space ☐ Basement w/plumbing ☐ Basement wo/plumbing

Comments:

Comments: DEH READY TO ISSUE PERMIT

1"=50'

INITIAL SITE SKETCH

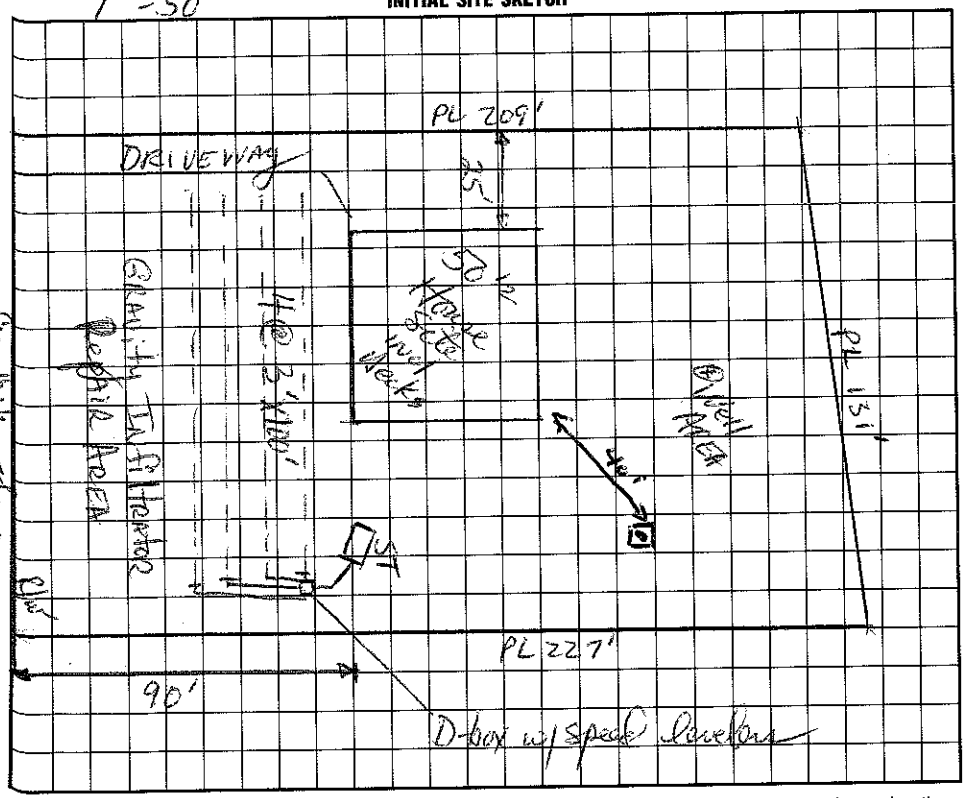

AS BUILT SKETCH

I understand that this permit can be suspended or revoked if any false information is supplied toward securing the permit/any unauthorized changes are made to the site/any unauthorized changes are made in the installation of the system. Improvement Permit is valid for 60 months from date of issuance.

Signed: Wesley Sparks, RS 9/23/95

Improvement Permit by: Patrick R. Hanson, RS date 4/23/95

Existing System Inspection by: date

Installed by: Rowan Septic Tank

Certificate of Completion by: date

Operation Permit by: Wesley Sparks RS. date 9/5/96

HEALTH DEPT. COPY: WHITE INSPECTION COPY (FINAL): GREEN OWNER COPY (FINAL): YELLOW INSPECTION COPY (INITIAL): PINK OWNER COPY (INITIAL): GOLD