# IREDELL COUNTY HEALTH DEPARTMENT

STATESVILLE 704-878-5305 MOORESVILLE 704-664-5281 4:00 Am

## IMPROVEMENT PERMIT / CERTIFICATE OF COMPLETION / OPERATION PERMIT / EXISTING SYSTEM INSPECTION

PROPERTY DESCRIPTION NO. 20538 DATE April 23, '95 TAX MAP NO. part of 2SA51 Watershed: ☑ Yes ☐ No WS IV

OWNER OR CONTRACTOR Krom Financial Services PHONE: Business 664-3671 Home

ADDRESS 19 Yacht Cove Rd., Mooresville 4638-89-7601

LOCATION Perth Rd. N. TR Cornelius Rd. TL Creek View Lane 2nd lot on Right

SUBDIVISION Mills Pond BLOCK / SECTION ______ LOT 33 LOT AREA 1.45 Ac SITE CLASS. PS per 1956 DESIGN FLOW 360 gpd L.T.A.R. .3

Septic Tank: 1000 Gallons; STB 825 Date 4/19/97
Pump Tank: ______ Gallons; PT ______ Date ______
Pump Make: ______ Model ______ Serial No. ______
Nitrification Field: No Fields 1 Square Feet 900 Linear Feet 300
No Lines 3 Trench Width 36" Max Trench Bottom Depth 36" Gravel Depth N/A

☑ New System ☐ Repair System Type: I, II, III, IV, V, VI
System Description: gravity Infiltrator
Repair System Description: same
Maintenance Agreement Required: ☐ Yes ☑ No

☑ House/Mod. Home ☐ Mobile Home ☐ Business ☐ Other ______
No. Bedrooms 3 No. Bathrooms 2 No. Employees ______

☐ Slab ☑ Crawl Space ☐ Basement w/plumbing ☐ Basement wo/plumbing


Water Supply: ☑ Individual ☐ Community ☐ Public

Comments:

Comments: DEV[illegible] TO [illegible] PERMIT AWS 9/23/95
Install as drawn.

1" = 100'

**INITIAL SITE SKETCH**

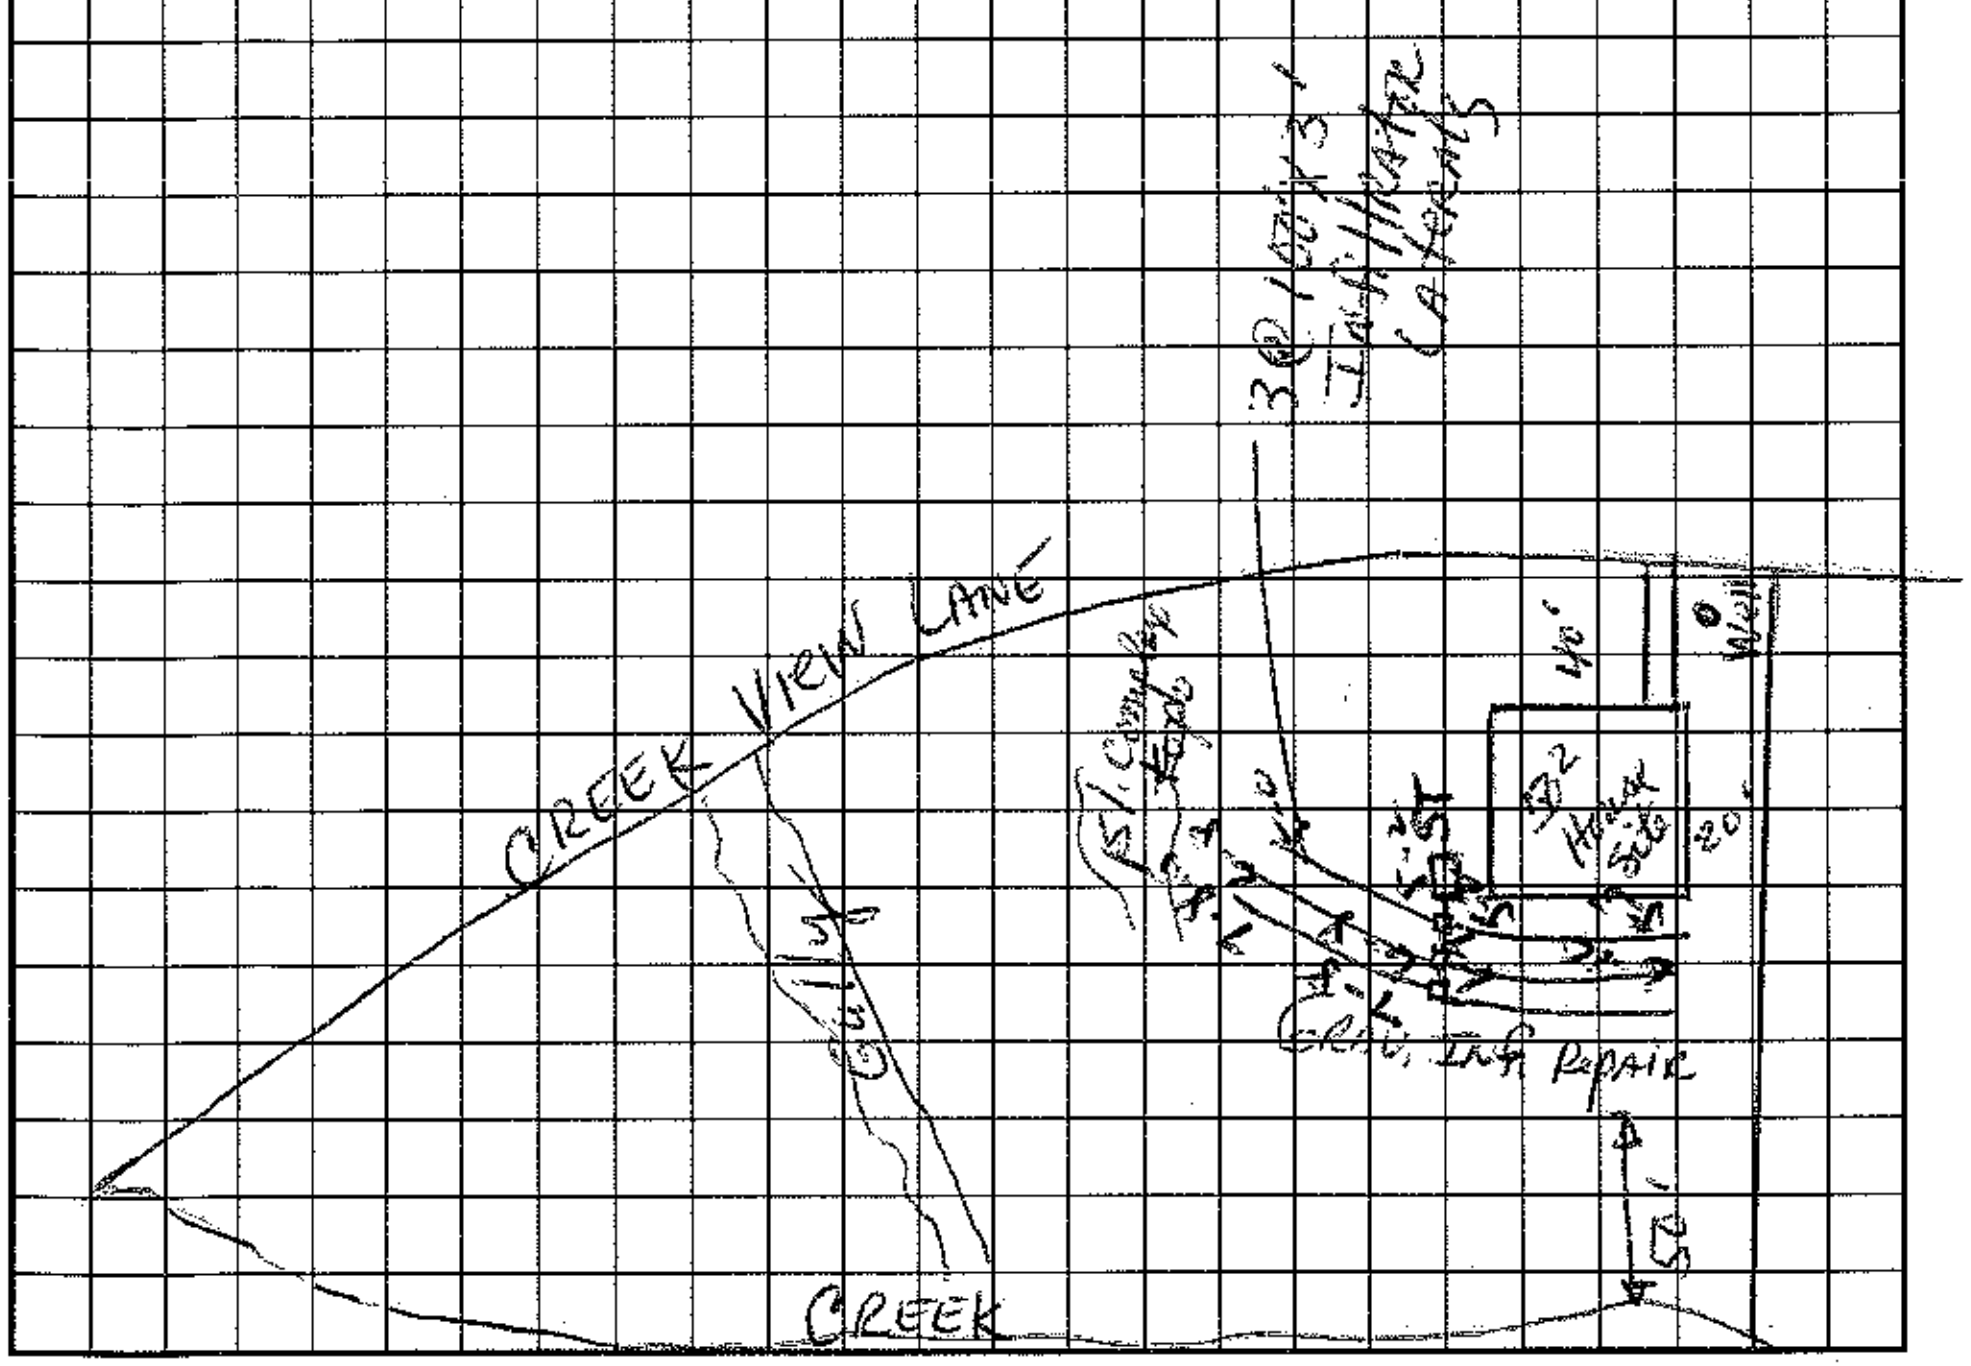


**AS BUILT SKETCH**

I understand that this permit can be suspended or revoked if any false information is supplied toward securing the permit/any unauthorized changes are made to the site/any unauthorized changes are made in the installation of the system. Improvement Permit is valid for 60 months from date of issuance.

Signed: X Wesley Sparks RS 9/23/95

Improvement Permit by: [signature], RS date 4/23/95

Existing System Inspection by: ______ date ______

Installed by: Rowan Septic Tank

Certificate of Completion by: Wesley Sparks RS. date 5/27/97

Operation Permit by: Wesley Sparks RS. date 5/27/97

HEALTH DEPT. COPY: WHITE INSPECTION COPY (FINAL): GREEN OWNER COPY (FINAL): YELLOW INSPECTION COPY (INITIAL): PINK OWNER COPY (INITIAL): GOLD