IREDELL COUNTY HEALTH DEPARTMENT

STATESVILLE 704-878-5305 MOORESVILLE 704-664-5281

IMPROVEMENT PERMIT / CERTIFICATE OF COMPLETION / OPERATION PERMIT / EXISTING SYSTEM INSPECTION

PROPERTY DESCRIPTION NO. 22211 DATE Dec 20, '95 TAX MAP NO. part of 2SA51 Watershed: ☑ Yes ☐ No

OWNER OR CONTRACTOR Krom Financial Services PHONE: Business _____ Home 1154CA 4638-89-7857

ADDRESS 149 Yacht Cove Rd. Mooresville

LOCATION Cornelius Rd. Turn on Creekview on left corner lot w/ Milbros Ln.

SUBDIVISION Mills Pond BLOCK / SECTION _____ LOT 88 LOT AREA ± 20,000 ft² SITE CLASS. PS per 1996 DESIGN FLOW 360 gpd. L.T.A.R. .35

Septic Tank: 1000 Gallons; STB 825 Date 3/10/96

Pump Tank: _____ Gallons; PT _____ Date _____

Pump Make: _____ Model _____ Serial No. _____

Nitrification Field: No Fields 1 Square Feet 840 Linear Feet 280

No Lines 4@70' Trench Width 36" Max Trench Bottom Depth 36" Gravel Depth N/A

☑ New System ☐ Repair System Type: I, II, III, IV, V, VI

System Description: gravity INFILTRATOR

Repair System Description: pumped INFILTRATOR

Maintenance Agreement Required: ☐ Yes ☑ No

☑ House/Mod. Home ☐ Mobile Home ☐ Business ☐ Other

No. Bedrooms 3 No. Bathrooms 2 No. Employees _____

☑ Slab ☑ Crawl Space ☐ Basement w/plumbing ☐ Basement wo/plumbing


Water Supply: ☑ Individual ☐ Community ☐ Public

Comments:

Comments:

367

INITIAL SITE SKETCH 1"=50'

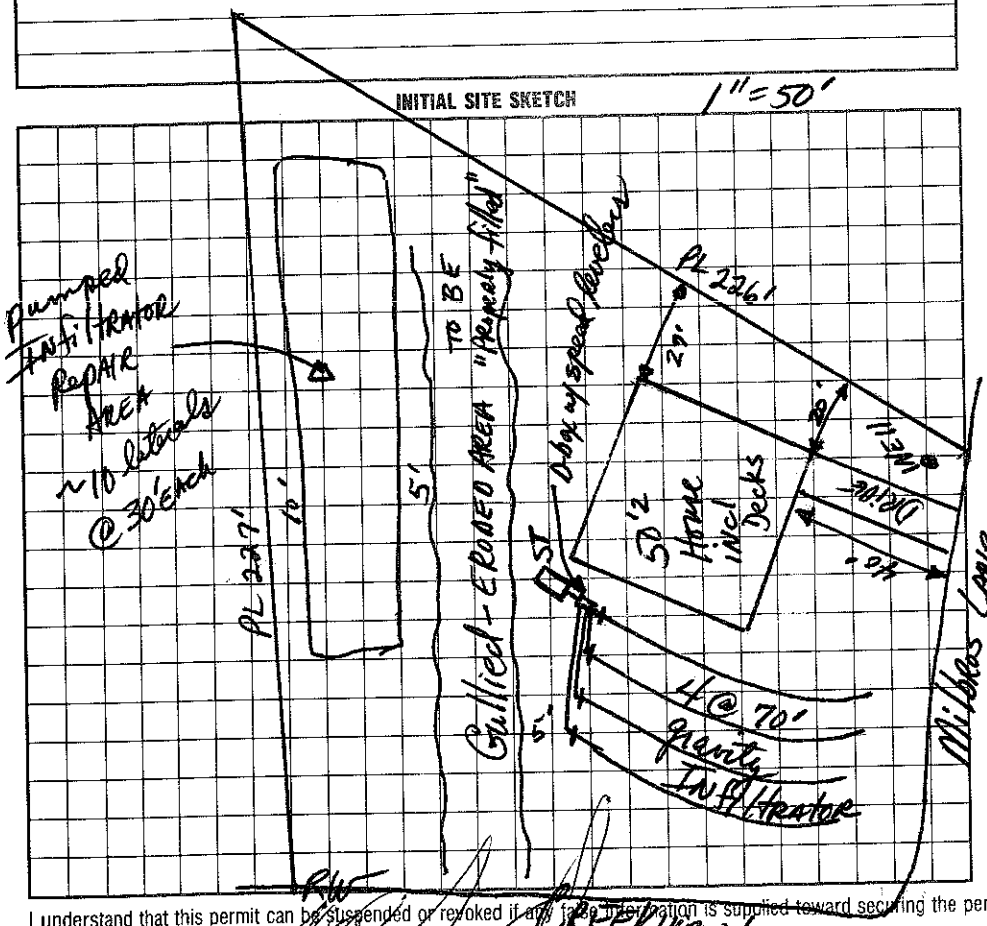

AS BUILT SKETCH

I understand that this permit can be suspended or revoked if any false information is supplied toward securing the permit/any unauthorized changes are made to the site/any unauthorized changes are made in the installation of the system.

Signed: X

Improvement Permit by: Dave R. Hinson, RS date 12-20-95

~~Existing System~~ Inspection by: D R Hinson, RS date Jan 11, '96

Authorization to Construct

Installed by: ROWAN SEPTIC

Certificate of Completion by: _____ date _____

Operation Permit by: C. Bob Green EHSI date 10/28/96

HEALTH DEPT. COPY: WHITE INSPECTION COPY (FINAL): GREEN OWNER COPY (FINAL): YELLOW INSPECTION COPY (INITIAL): PINK OWNER COPY (INITIAL): GOLD