IREDELL COUNTY HEALTH DEPARTMENT

STATESVILLE 704-878-5305 MOORESVILLE 704-664-5281

IMPROVEMENT PERMIT / CERTIFICATE OF COMPLETION / OPERATION PERMIT / EXISTING SYSTEM INSPECTION

PROPERTY DESCRIPTION NO. 20761 DATE April 6, '95 TAX MAP NO. part of 7 25A57 4638 89 8119 Watershed: ☑ Yes ☐ No

OWNER OR CONTRACTOR Keem Financial Services PHONE: Business 664-3671 Home WSIV

ADDRESS 19 Yadkin Cove Rd. Mooresville

LOCATION Perth Rd N. to R Cornelius Rd. Approx 600' on left

SUBDIVISION Mills Forest West BLOCK / SECTION ____ LOT 30 LOT AREA 1.97 Ac SITE CLASS. FS DESIGN FLOW 360 gpd L.T.A.R. .3

Septic Tank: 1000 Gallons; STB 825 Date 3/7/96

Pump Tank: ____ Gallons; PT ____ Date ____

Pump Make: ____ Model ____ Serial No. ____

Nitrification Field: No Fields 1 Square Feet 1200 Linear Feet ~~400~~ 300

No Lines 2 Trench Width 36" Max Trench Bottom Depth 30" Gravel Depth ____

☑ New System ☐ Repair System Type: I, II, (III), IV, V, VI

System Description: pumped conventional

Repair System Description: Same

Maintenance Agreement Required: ☐ Yes ☑ No

☑ House/Mod. Home No. Bedrooms 3

☐ Mobile Home No. Bathrooms 2

☐ Business No. Employees ____

☐ Other ____

☐ Slab ☑ Crawl Space ☐ Basement w/plumbing ☐ Basement wo/plumbing


Water Supply:
☑ Individual
☐ Community
☐ Public

Comments: laterals to follow contour.

Comments:
DEVELOPER
PERMIT

1"=100'

INITIAL SITE SKETCH

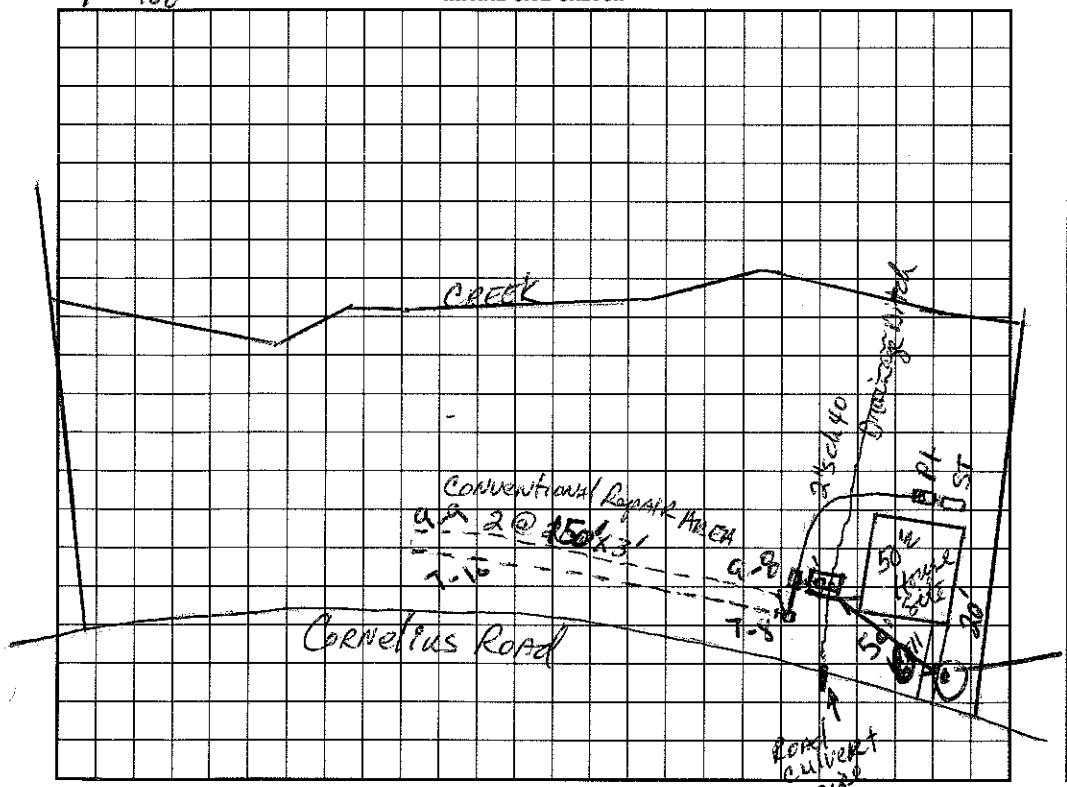

AS BUILT SKETCH

I understand that this permit can be suspended or revoked if any false information is supplied toward securing the permit/any unauthorized changes are made to the site/any unauthorized changes are made in the installation of the system. Improvement Permit is valid for 60 months from date of issuance.

Signed: [signature]

Improvement Permit by: Mark R. Hinson, RS date 4/6/95

Existing System Inspection by: ____ date ____

Installed by: Rowan Septic Tank

Certificate of Completion by: ____ date ____

Operation Permit by: Wesley Sparks RS. date 10/22/96

HEALTH DEPT. COPY: WHITE INSPECTION COPY (FINAL): GREEN OWNER COPY (FINAL): YELLOW INSPECTION COPY (INITIAL): PINK OWNER COPY (INITIAL): GOLD