IREDELL COUNTY HEALTH DEPARTMENT

STATESVILLE 704-878-5305 MOORESVILLE 704-664-5281

IMPROVEMENT PERMIT / CERTIFICATE OF COMPLETION / OPERATION PERMIT / EXISTING SYSTEM INSPECTION

PROPERTY DESCRIPTION NO. 22210 DATE Dec 20, '95 TAX MAP NO. part of 25A51 4638 89 8956 Watershed: ☑ Yes ☐ No

OWNER OR CONTRACTOR Krom Financial Services PHONE: Business _____ Home _____ WS4CA

ADDRESS 199 Yacht Cove Rd. Mooresville

LOCATION Cornelius Rd. Turn on Creekview Dr Milbros Ln. on left

SUBDIVISION Mills Pond BLOCK / SECTION _____ LOT 89 LOT AREA > 20,000ft² SITE CLASS PSpm. 1956 DESIGN FLOW 360 gpd L.T.A.R. ~.35

Septic Tank: 1000 Gallons; STB 825 Date 4-6-96

Pump Tank: 1000 Gallons; PT 47 Date 4-5-96

Pump Make: Zoeller Model N98 Serial No. _____

Nitrification Field: No Fields 1 Square Feet 840 Linear Feet 280

No Lines 4@70' Trench Width 36" Max Trench Bottom Depth 36" Gravel Depth NA

☑ New System ☐ Repair System Type: I, II, (III) IV, V, VI

System Description: pumped-pm-Infiltrator

Repair System Description: same

Maintenance Agreement Required: ☐ Yes ☑ No

☑ House/Mod. Home No. Bedrooms 3

☐ Mobile Home No. Bathrooms 2

☐ Business No. Employees _____

☐ Other _____

☐ Slab ☑ Crawl Space ☐ Basement w/plumbing ☐ Basement wo/plumbing

Water Supply: ~~☑ Individual~~ ☐ Community ☐ Public


Comments:

Comments: Lines, Tanks, Pressure tested 6/12/96

Electrical checked on 6/19/96 to complete System. (Poly) RWS

1" = 50'

INITIAL SITE SKETCH

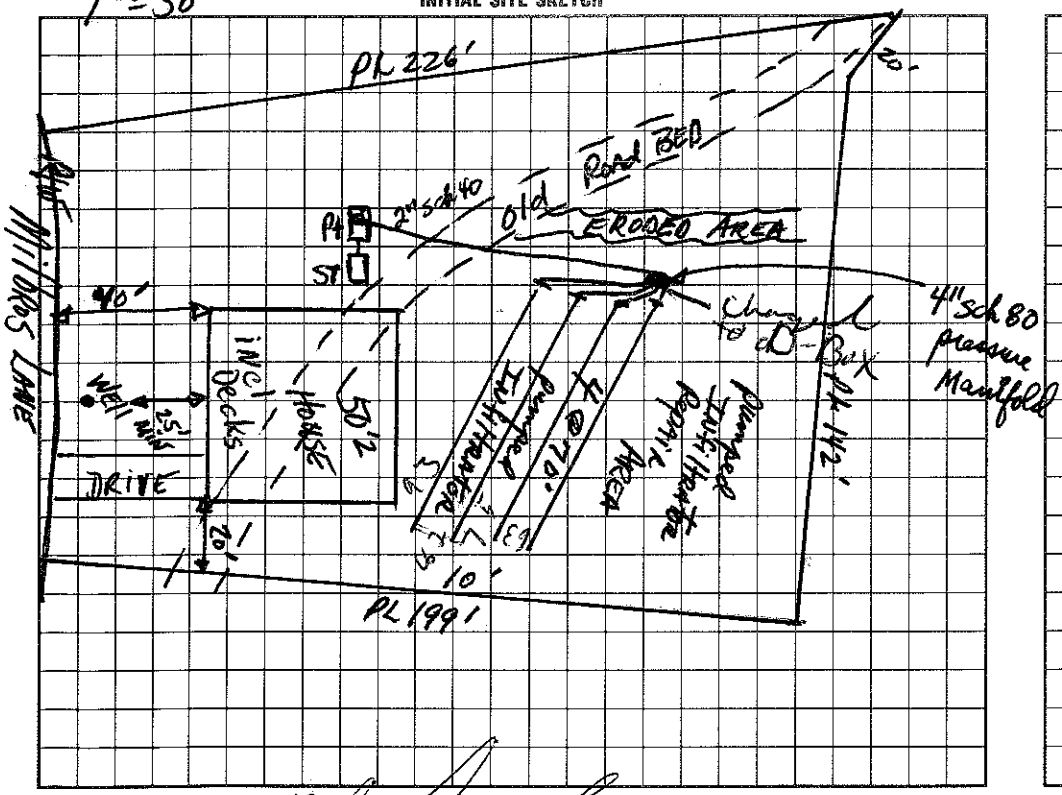

AS BUILT SKETCH

I understand that this permit can be suspended or revoked if any false information is supplied toward securing the permit/any unauthorized changes are made to the site/any unauthorized changes are made in the installation of the system.

Signed: _____

Improvement Permit by: David R. Hunter, RS date 12-20-95

Existing System Inspection by: D. Riffenburgh, RS date Jan 11, 96

to construct

Installed by: Rowan Septic Tank

Certificate of Completion by: _____ date _____

Operation Permit by: Wesley Sparks R.S. date 6/19/96

HEALTH DEPT. COPY: WHITE INSPECTION COPY (FINAL): GREEN OWNER COPY (FINAL): YELLOW INSPECTION COPY (INITIAL): PINK OWNER COPY (INITIAL): GOLD