IREDELL COUNTY HEALTH DEPARTMENT

STATESVILLE 704-878-5305 MOORESVILLE 704-664-5281

IMPROVEMENT PERMIT / CERTIFICATE OF COMPLETION / OPERATION PERMIT / EXISTING SYSTEM INSPECTION

PROPERTY DESCRIPTION NO. 22169 DATE Feb 6, '96 TAX MAP NO. part of 25A51 Watershed: ☑ Yes ☐ No

OWNER OR CONTRACTOR Iron Financial Services PHONE: Business Home 4638-89-9295

ADDRESS 149 Yacht Cove Rd. Mooresville

LOCATION Cornelius Rd. Turn on Creekview on Right across from Wadsworth Ln.

SUBDIVISION Mills Pond BLOCK / SECTION LOT 35 LOT AREA .57Ac SITE CLASS. PSpt. 1994 DESIGN FLOW 360 gpd L.T.A.R. .3

Septic Tank: 1000 Gallons; STB 825 Date 7/18/96

Pump Tank: Gallons; PT Date

Pump Make: Model Serial No.

Nitrification Field: No Fields 1 Square Feet 900 Linear Feet 300

No Lines 3@100' Trench Width 36" Max Trench Bottom Depth 36" Gravel Depth NA

☑ New System ☐ Repair System Type: I, II, III, IV, V, VI

System Description: gravity Infiltrator

Repair System Description: same

Maintenance Agreement Required: ☐ Yes ☑ No

☑ House/Mod. Home No. Bedrooms 3

☐ Mobile Home No. Bathrooms 2

☐ Business No. Employees

☐ Other

☐ Slab ☑ Crawl Space ☐ Basement w/plumbing ☐ Basement wo/plumbing


Water Supply: ☑ Individual ☐ Community ☐ Public

Comments:

Comments:

1"=50'

INITIAL SITE SKETCH

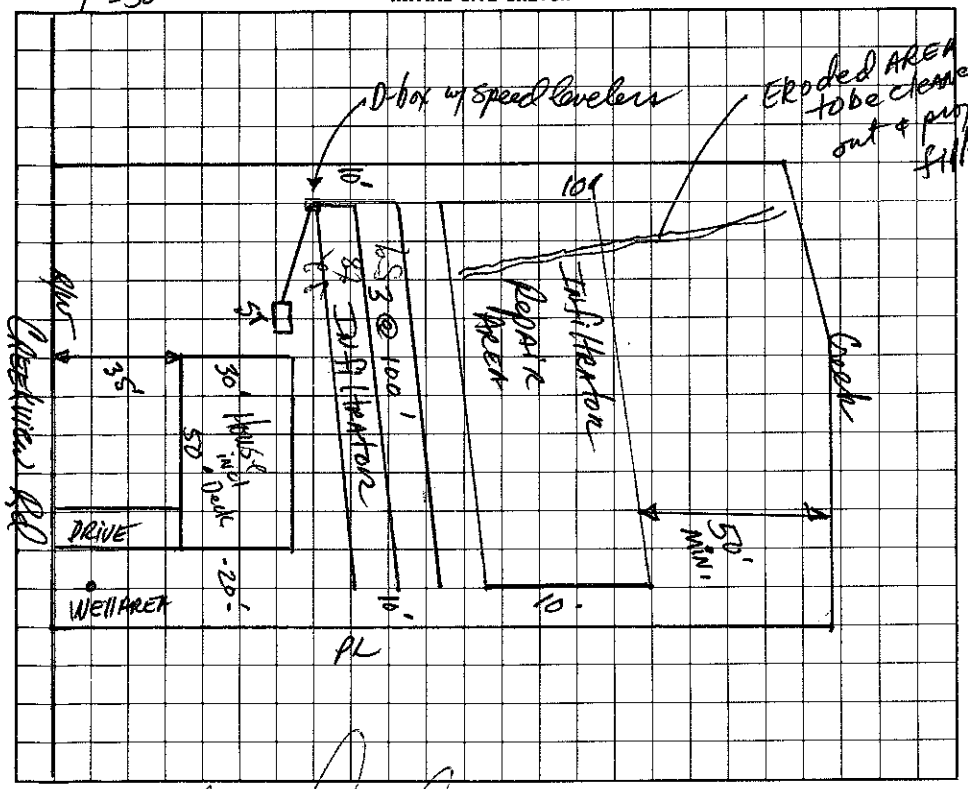

AS BUILT SKETCH

I understand that this permit can be suspended or revoked if any false information is supplied toward securing the permit/any unauthorized changes are made to the site/any unauthorized changes are made in the installation of the system.

Signed:

Improvement Permit by: Harold R. Hunsucker, RS date 2-6-96

Existing System Inspection by: Authorization to construct HRHunsucker, RS date 2-6-96

Installed by: Rowan Septic

Certificate of Completion by: date

Operation Permit by: date 8/23/96

HEALTH DEPT. COPY: WHITE INSPECTION COPY (FINAL): GREEN OWNER COPY (FINAL): YELLOW INSPECTION COPY (INITIAL): PINK OWNER COPY (INITIAL): GOLD