IREDELL COUNTY HEALTH DEPARTMENT

STATESVILLE 704-878-5305 MOORESVILLE 704-664-5281

IMPROVEMENT PERMIT / CERTIFICATE OF COMPLETION / OPERATION PERMIT / EXISTING SYSTEM INSPECTION

PROPERTY DESCRIPTION NO. 22201 DATE Dec 19, 195 TAX MAP NO. part of 25451 Watershed: ☑ Yes ☐ No

OWNER OR CONTRACTOR Kyom financial Services PHONE: Business _____ Home _____

ADDRESS 149 Yacht Cove Rd., Mooresville

LOCATION Congdyn Rd. Turn on Creekview TL Milbros Cv. on Right - corner lot

SUBDIVISION Mills Pond BLOCK / SECTION _____ LOT 78 LOT AREA .68ac SITE CLASS PS DESIGN FLOW 360gpd L.T.A.R. .3

Septic Tank: 1000 Gallons; STB 825 Date 4/21/96

Pump Tank: _____ Gallons; PT _____ Date _____

Pump Make: _____ Model _____ Serial No. _____

Nitrification Field: No Fields 1 Square Feet 1200 Linear Feet 400

No Lines 4@100' Trench Width 36" Max Trench Bottom Depth 36" Gravel Depth 12"

☑ New System ☐ Repair System Type: I. II. III. IV. V. VI

System Description: Gravity Conventional

Repair System Description: gravity INF - on conv.

Maintenance Agreement Required: ☐ Yes ☑ No

☑ House/Mod. Home No. Bedrooms 3

☐ Mobile Home No. Bathrooms 2

☐ Business No. Employees _____

☐ Other _____

☑ Slab ☐ Crawl Space ☐ Basement w/plumbing ☐ Basement wo/plumbing


Water Supply: ☑ Individual ☐ Community ☐ Public

Comments:

Comments:

1"=50'

INITIAL SITE SKETCH

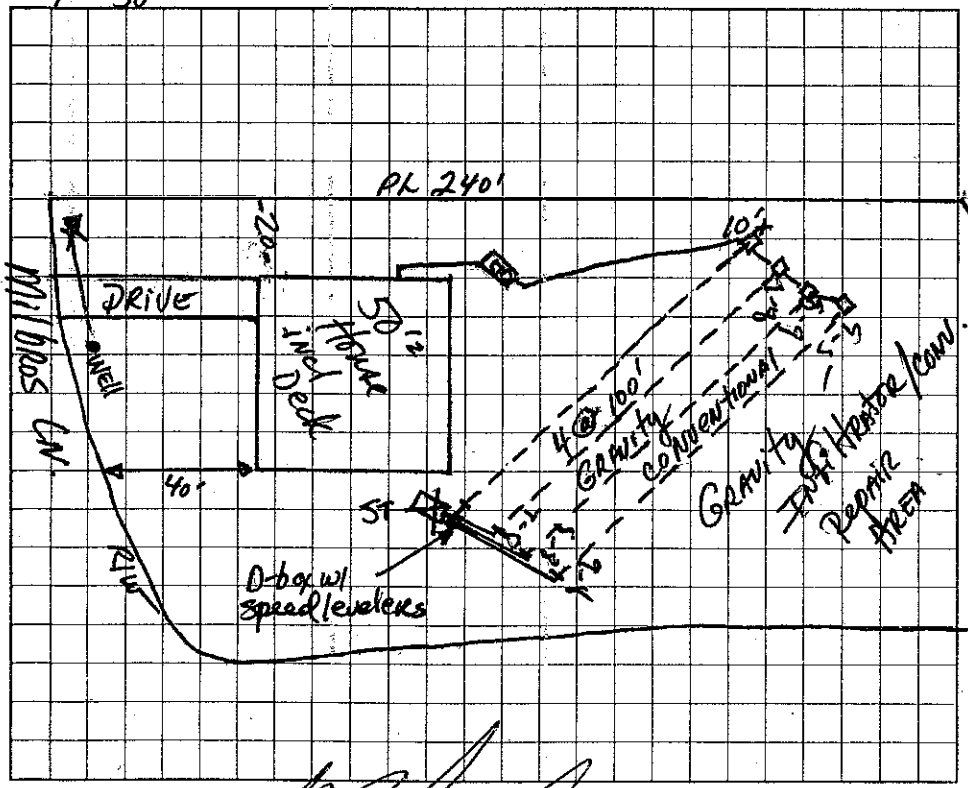

AS BUILT SKETCH

I understand that this permit can be suspended or revoked if any false information is supplied toward securing the permit/any unauthorized changes are made to the site/any unauthorized changes are made in the installation of the system.

Signed: X

Improvement Permit by: _____ date Dec. 19, 95

Authorization to construct

Existing System Inspection by: _____ date 1-12-96

Installed by: Rowan Septic Tank

Certificate of Completion by: _____ date _____

Operation Permit by: Wesley Sparks RS. date 6/12/96

HEALTH DEPT. COPY: WHITE INSPECTION COPY (FINAL): GREEN OWNER COPY (FINAL): YELLOW INSPECTION COPY (INITIAL): PINK OWNER COPY (INITIAL): GOLD