IREDELL COUNTY HEALTH DEPARTMENT

STATESVILLE 704-878-5305 MOORESVILLE 704-664-5281

4638903732

IMPROVEMENT PERMIT / CERTIFICATE OF COMPLETION / OPERATION PERMIT / EXISTING SYSTEM INSPECTION

PROPERTY DESCRIPTION NO. 17351 DATE 11/4/93 TAX MAP NO. 2P-5-A-5 Watershed: ☑ Yes ☐ No

OWNER OR CONTRACTOR GEORGE MOSER PHONE: Business _____ Home _____

ADDRESS 7045 CAINDALE DR. WINSTON SALEM, NC

LOCATION WILSON LAKE RD ON (L) BEFORE LOG HOUSE

SUBDIVISION CLFT BLOCK / SECTION 11 LOT 5 LOT AREA 20,000 FT2 SITE CLASS. P DESIGN FLOW 360 L.T.A.R. 3-.35

Septic Tank: 1600 Gallons; STB 794 Date 4/94

Pump Tank: _____ Gallons; PT _____ Date _____

Pump Make: _____ Model _____ Serial No. _____

Nitrification Field: No Fields 1 Square Feet 1170 Linear Feet 390

No Lines 3 Trench Width 3' Max Trench Bottom Depth 30" Gravel Depth 12"

☐ New System ☐ Repair System Type: I, (II), III, IV, V, VI

System Description: CONV.

Repair System Description: _____

Maintenance Agreement Required: ☐ Yes ☑ No

☑ House/Mod. Home No. Bedrooms 3

☐ Mobile Home No. Bathrooms 2

☐ Business No. Employees _____

☐ Other _____


☐ Slab ☐ Crawl Space ☑ Basement w/plumbing ☐ Basement wo/plumbing

Water Supply: ☑ Individual ☐ Community ☐ Public

Comments: MOBILE HOME TO BE RELOCATED - DRAINFIELD IN AREA WHERE MH NOW SITS.

Comments: installed as shown.

INITIAL SITE SKETCH

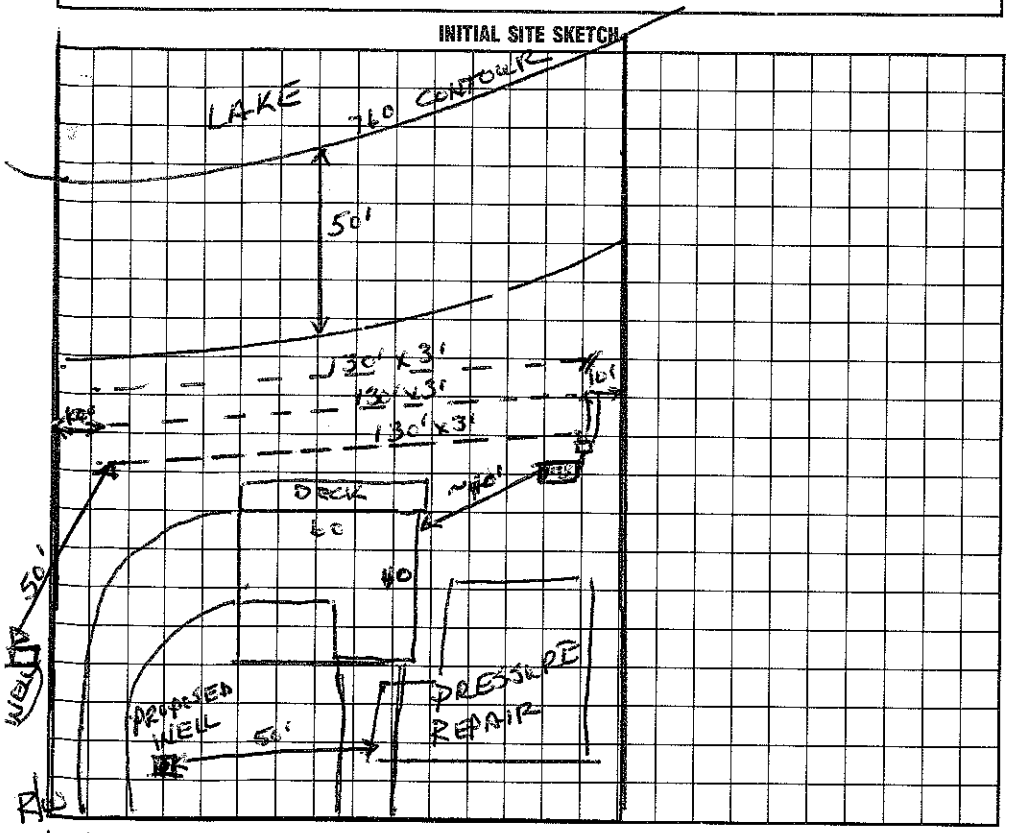

AS BUILT SKETCH

I understand that this permit can be suspended or revoked if any false information is supplied toward securing the permit/any unauthorized changes are made to the site/any unauthorized changes are made in the installation of the system. Improvement Permit is valid for 60 months from date of issuance.

Signed: T Glen Parker

Improvement Permit by: Wesley Sparks RS. date 11/4/93

Existing System Inspection by: _____ date _____

Installed by: Claudius Morrison

Certificate of Completion by: Wesley Sparks RS. date 10/11/94

Operation Permit by: _____ date _____

HEALTH DEPT. COPY: WHITE INSPECTION COPY (FINAL): GREEN OWNER COPY (FINAL): YELLOW INSPECTION COPY (INITIAL): PINK OWNER COPY (INITIAL): GOLD