IREDELL COUNTY HEALTH DEPARTMENT

Statesville Office (704) 878-5305 Mooresville Office (704) 660-3625 PERMIT # 208154

IMPROVEMENT PERMIT / AUTHORIZATION TO CONSTRUCT / OPERATION PERMIT / EXISTING SYSTEM

PIN # 4638-90-7278.000

APPLICANT: CARLTON + JC DIGGINS APPLICANT ADDRESS: 334 ERWIN RD MOORESVILLE NC

SITE ADDRESS: 334 ERWIN RD. MOORESVILLE NC PHONE: 704-746-6479 ALT. PHONE:

SITE DIRECTIONS: HWY 150 TO ERWIN RD., ON R NEAR END

SUBDIVISION: LYNN BROOK ACRES SECTION: LOT # 13 LOT AREA: .58 ACRE DESIGN FLOW: EXISTING L.T.A.R.: EXISTING

Septic Tank EXISTING (gal) STB Date
Pump Tank (gal) PT Date
Pump Make Model Serial #
Nitrification Fields EX 1 # Lines EX Linear Ft: EX
Trench Width EXISTING Max. Trench Bottom Depth EXISTING Gravel Depth EXISTING

☐ New System ☐ Repair ☐ Expansion System Type: I (II) III IV V VI
System Description: EXISTING CONVENTIONAL BED
Repair System Description: EXISTING
Maintenance Agreement Required: ☐ YES ☒ NO
☒ GRAVITY ☐ PRESSURE


☒ Residence No. Bedrooms EX
☐ Business No. Persons EX
☐ Other No. Employees
☐ Slab ☐ Crawl Space
☒ Basement w/plumbing ☐ Basement w/o plumbing

Water Supply: ☒ Private ☐ Public ☐ Community

Comments / Conditions: ADDITIONS PROPOSED WHERE EXISTING STRUCTURES ARE. BESIDES A MINOR EXPANSION TO STEPS ON PORCH. APPEARS TO MEET SETBACKS AND SEPTIC SYSTEM APPEARED TO BE FUNCTIONING AT TIME OF INSPECTION.

INITIAL SITE SKETCH

AS BUILT SKETCH

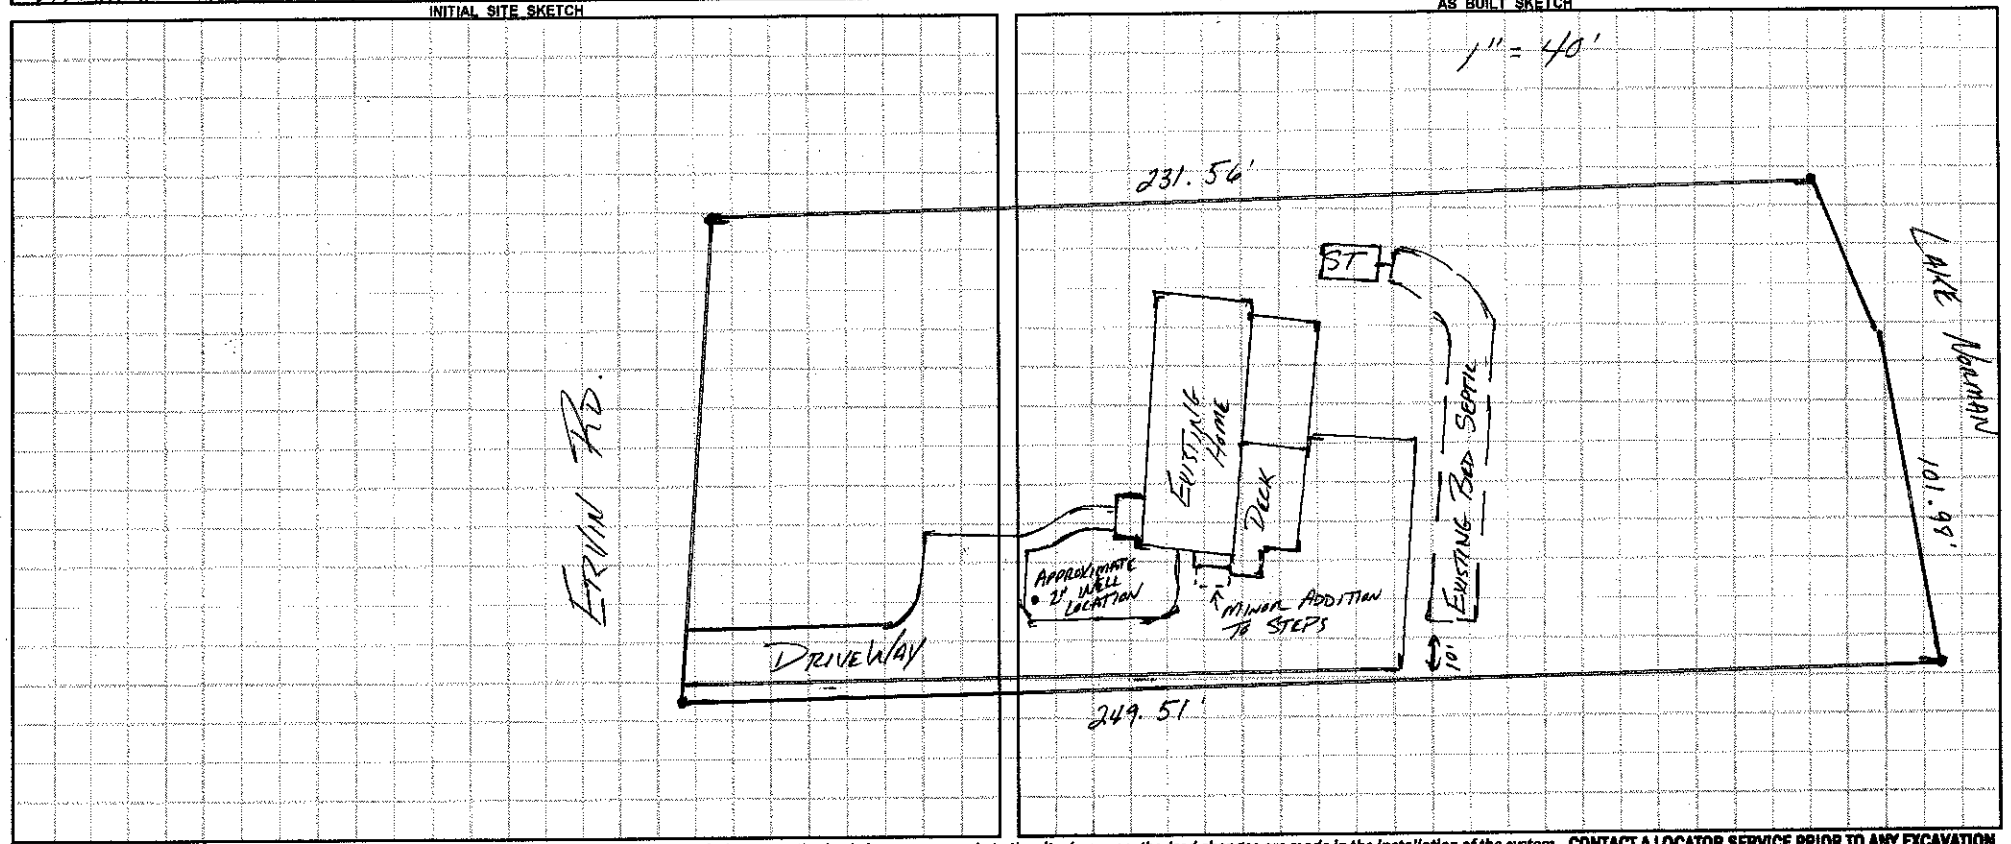

Permit can be suspended or revoked if any false information is supplied toward securing the permit / any unauthorized changes are made to the site / any unauthorized changes are made in the installation of the system. **CONTACT A LOCATOR SERVICE PRIOR TO ANY EXCAVATION**

☐ **IMPROVEMENT PERMIT** *with plat valid without expiration.* ☐ **IMPROVEMENT PERMIT** *with site plan valid for 60 mos.* ☐ **AUTHORIZATION TO CONSTRUCT** *valid for period equal to IMPROVEMENT PERMIT--not to exceed 60 mo.*

Owner / Applicant Signature: Date: 5/4/15 Installed by:

IMPROVEMENT PERMIT by: Date: OPERATION PERMIT by: Date:

AUTHORIZATION TO CONSTRUCT by: Date: Existing System Inspected by: Date: 5/1/15

Health Dept. Copy - WHITE Applicant (Final Approval) - YELLOW Applicant (Conditional Approval) - PINK