IREDELL COUNTY HEALTH DEPARTMENT

Statesville Phone TR 3-7271 Mooresville Phone NO 3-1271

PERMIT TO INSTALL SEPTIC TANK

Permit NO. 268 Permit Date 12-5-1972

Owner Clyde Stutts Address Mooresville

Installed By Sam Oswalt Address Troutman


Location of Property 150 West TR on 1304 1mi on Right

Tank		Capacity		Length of Lines		Fixtures	
Block	(X)	1000	(✓)	225'	( )	No. of Baths	(1)
Precast	(✓)	1250	( )	250'	( )	Dishwasher	(no
		1500	( )	Other 120'		Garbage Grdr.	(no
		Other				Other Washing machine	

NOTIFY HEALTH DEPARTMENT AT LEAST EIGHT HOURS BEFORE TANK IS TO BE INSPECTED.

Final Inspection 12-5-1972 Approved (✓) Disapproved ( )

Remarks Line was short due to layout of lot Double amount of stone was used in system regular maintance is needed.

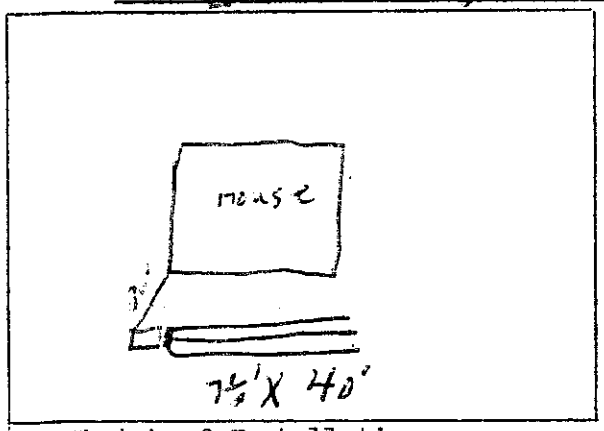

Sketch of Installation

J. C. Moore

Sanitarian