ICHD - ENVIRONMENTAL HEALTH DIVISION

Statesville Office (704) 878-5305 | MW Mooresville Office (704) 660-3625

PERMIT # AP 2023-12982

SEPTIC: IMPROVEMENT PERMIT / AUTHORIZATION TO CONSTRUCT / OPERATION PERMIT / EXISTING SYSTEM

PIN # 4638 -- 91 -- 6903

APPLICANT/OWNER: Becky Siemieniec | APPLICANT ADDRESS: 2715 Wise Ave NW, Canton, OH

SITE ADDRESS: 315 Wilson Lake Rd, Mooresville 28117 | PHONE: 704-746-3084 | ALT. PHONE

SITE DIRECTIONS: Perth - Lakeshore School - Wilson Lake | SAP CONTROLLED: ☐ YES ☐ NO

SUBDIVISION: CL&T | SECTION: 11 | LOT #: 14 | LOT AREA: .75 acres | DESIGN FLOW: EX | L.T.A.R.: EX


Septic Tank	1000	(gal)	STB 760	Date	10/28/22	☐ New System	☒ Repair	☐ Expansion	System Type: I (II) III IV V VI	☒ Residence	No. Bedrooms 3
Pump Tank		(gal)	PT	Date		System Description:	EXISTING			☐ Business	No. Persons 6
Pump Make		Model		Serial #		Repair System Description:	Tank Replacement			☐ Other	No. Employees
# Nitrification Fields	EX	# Lines	EX	Linear Ft	EX	Maintenance Agreement Required:	☐ YES	☒ NO		☐ Slab	☒ Crawl Space
Trench Width	EX	Trench Bottom Depth(Low side)	EX	Gravel Depth	EX	☒ GRAVITY	☐ PRESSURE			☐ Basement w/plumbing	☐ Basement w/o plumbing

Water Supply: ☒ Private ☐ Public ☐ Community

Comments / Conditions: Pump, crush, & fill old tank. Replace distribution if necessary. New tank has already been installed at the time of this permit.


System appeared to be working at time of inspection. Do not drive, park, pave, or grade over septic system. New D-Box was installed.

INITIAL SITE SKETCH

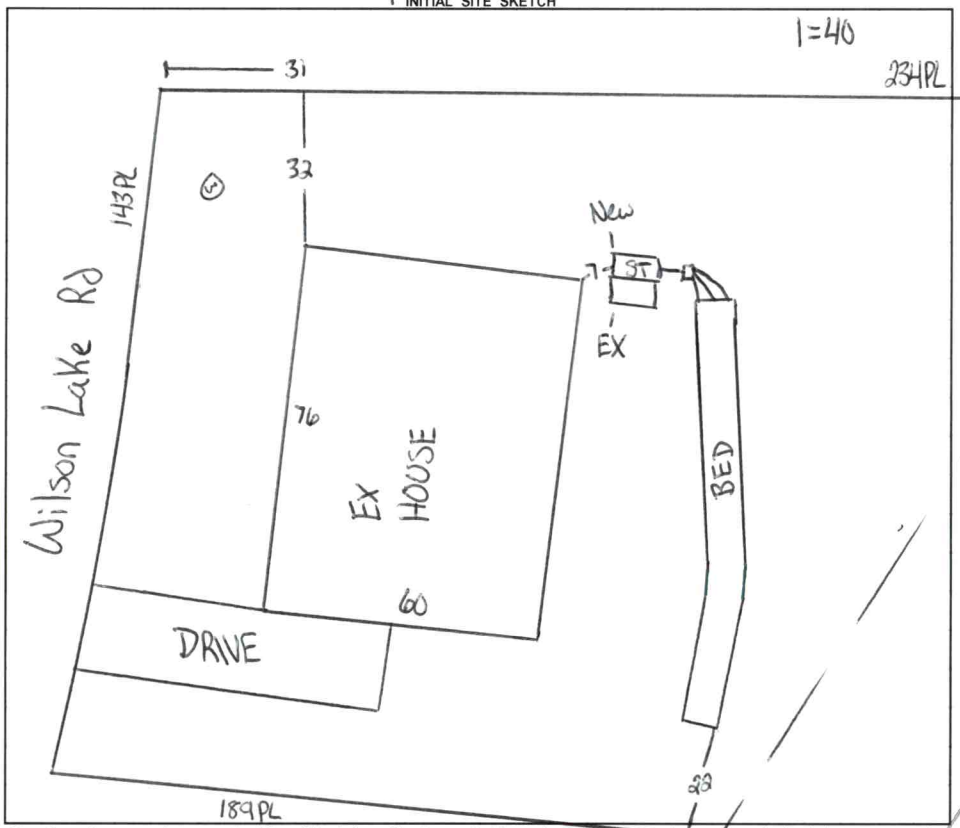

AS BUILT SKETCH

FOR SEPTIC FINAL INSPECTION CALL: 704-664-3703 between 8am-9am
the day the inspection is needed. Be sure to speak with an inspector to confirm your time.

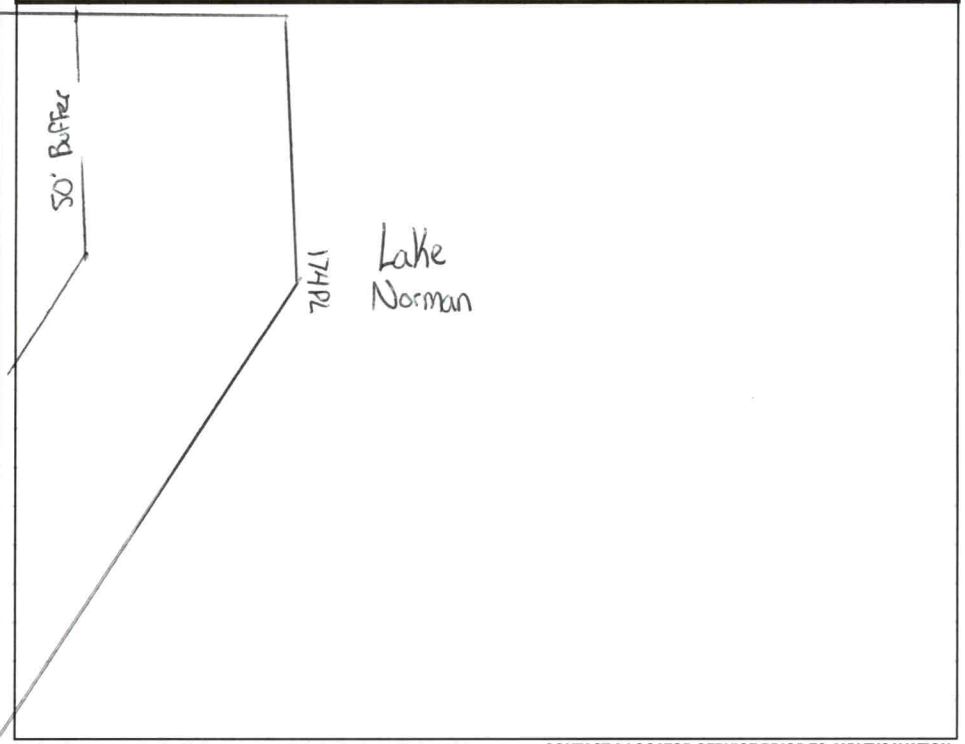

Permit can be suspended or revoked if any false information is supplied toward securing the permit / any unauthorized changes are made to the site / any unauthorized changes are made in the installation of the system. **CONTACT A LOCATOR SERVICE PRIOR TO ANY EXCAVATION**


☐ **IMPROVEMENT PERMIT** ***with plat*** *valid without expiration.* ☒ **IMPROVEMENT PERMIT** ***with site plan*** *valid for 60 mos.* ☒ **AUTHORIZATION TO CONSTRUCT** *valid for period equal to IMPROVEMENT PERMIT--not to exceed 60 mo.*

Owner / Applicant Signature: Online Signature | Date: | Installed by: Stevens Septic

IMPROVEMENT PERMIT by: Cary Wil | Date: 1/13/23 | OPERATION PERMIT by: Cary Wil | Date: 1/25/23

AUTHORIZATION TO CONSTRUCT by: Cary Wil | Date: 1/13/23 | Existing System Inspected by: | Date:

FOR SEPTIC FINAL INSPECTION: CALL 704-664-3703 between 8am-9am the day the inspection is needed.

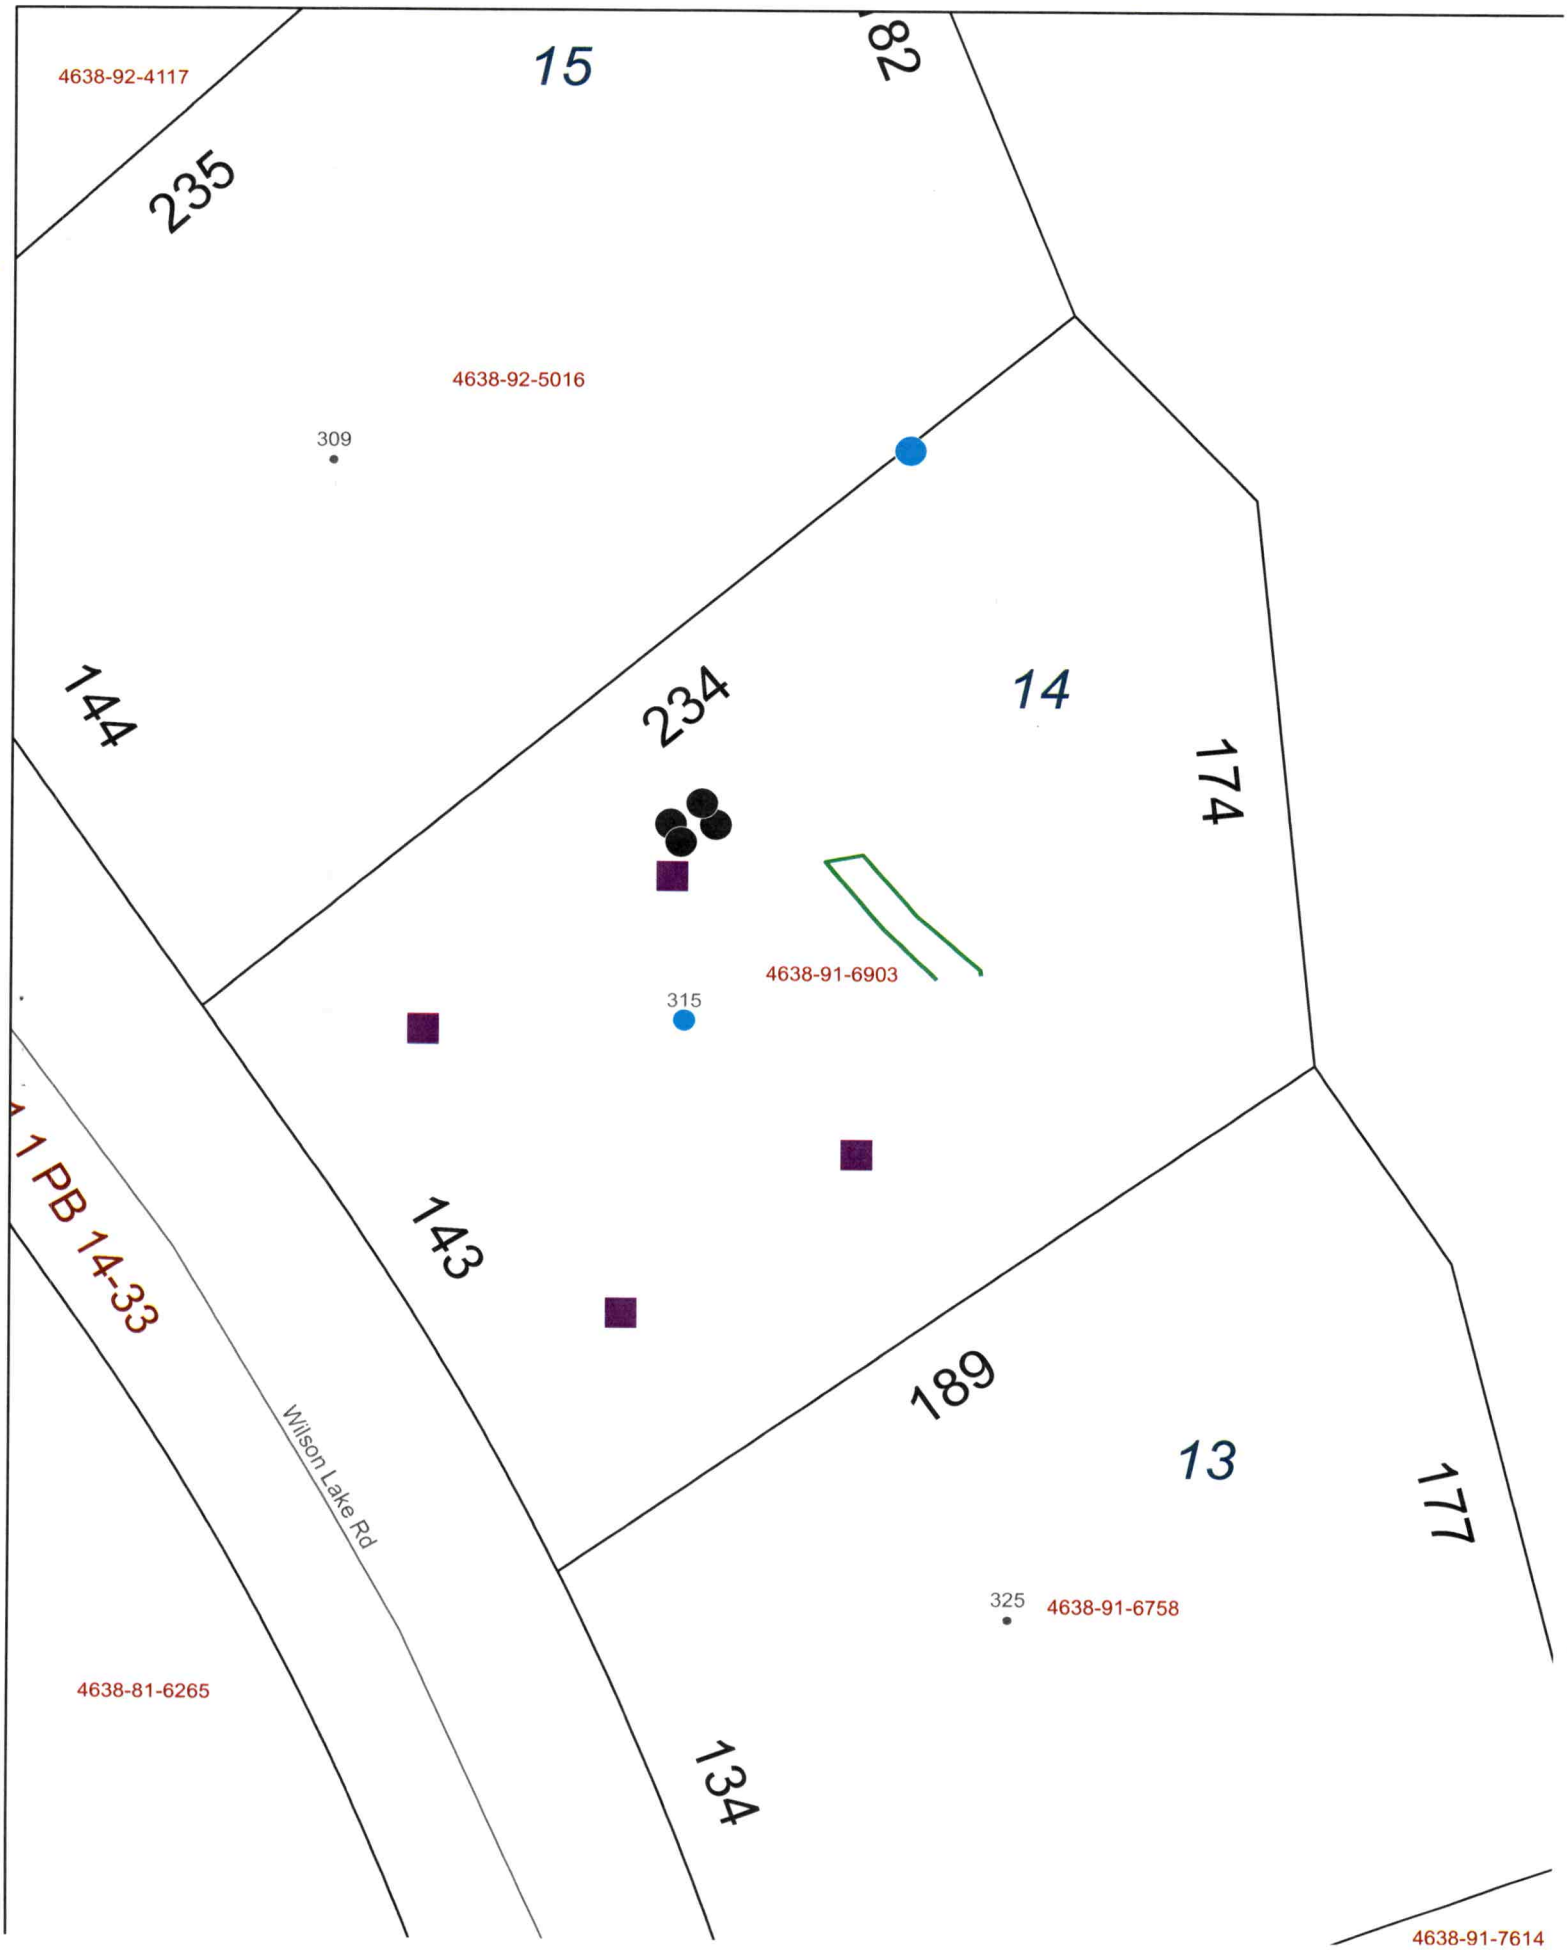
4638-92-4117
15
28
235
4638-92-5016
309
144
234
14
174
4638-91-6903
315
1 PB 14-33
143
189
13
177
Wilson Lake Rd
325
4638-91-6758
4638-81-6265
134
4638-91-7614

ICHD - ENVIRONMENTAL HEALTH DIVISION

Statesville Office (704) 878-5305 DW Mooresville Office (704) 660-3625 PERMIT # AP 320087

SEPTIC: IMPROVEMENT PERMIT / AUTHORIZATION TO CONSTRUCT / OPERATION PERMIT / EXISTING SYSTEM

PIN # 4638 -- 91 -- 6903

APPLICANT/OWNER: Mary Quinn Hancock APPLICANT ADDRESS: 315 Wilson Lake Rd Mooresville, NC

SITE ADDRESS: 315 Wilson Lake Rd Mooresville, NC 28117 PHONE: 704747-6186 ALT. PHONE

SITE DIRECTIONS: Hwy 150 W TR Peeth Rd TR by Lakeshore School TL Wilson Lake on left SAP CONTROLLED: N/A ☐ YES ☐ NO

SUBDIVISION: 1 & T SECTION: 11 LOT # 14 LOT AREA: .75Ac DESIGN FLOW: 360 gpd L.T.A.R.:

Septic Tank Exist (gal) STB Date

Pump Tank (gal) PT Date

Pump Make Model Serial #

Nitrification Fields # Lines Existing Linear Ft

Trench Width Trench Bottom Depth (Low side) Gravel Depth

☐ New System ☐ Repair ☐ Expansion System Type: I (II) III IV V VI

System Description: Existing Gravity (Gravel) Conventional

Repair System Description: Exempt Recorded in 1967

Maintenance Agreement Required: ☐ YES ☒ NO

☒ GRAVITY ☐ PRESSURE

☒ Residence No. Bedrooms 3

☐ Business No. Persons 6

☐ Other No. Employees

☐ Slab ☒ Crawl Space

☐ Basement w/plumbing ☐ Basement w/o plumbing

Water Supply: ☒ Private ☐ Public ☐ Community


Comments / Conditions: Note: Existing well abandoned 5/4/22 No Vehicular or Construction traffic over existing Septic System.

Must keep new house a minimum of 5ft from Existing Septic System. Foundation drains 10ft

Existing Septic System "appears" to be functioning ok at time of AS BUILT SKETCH

INITIAL SITE SKETCH

Scale 1:60

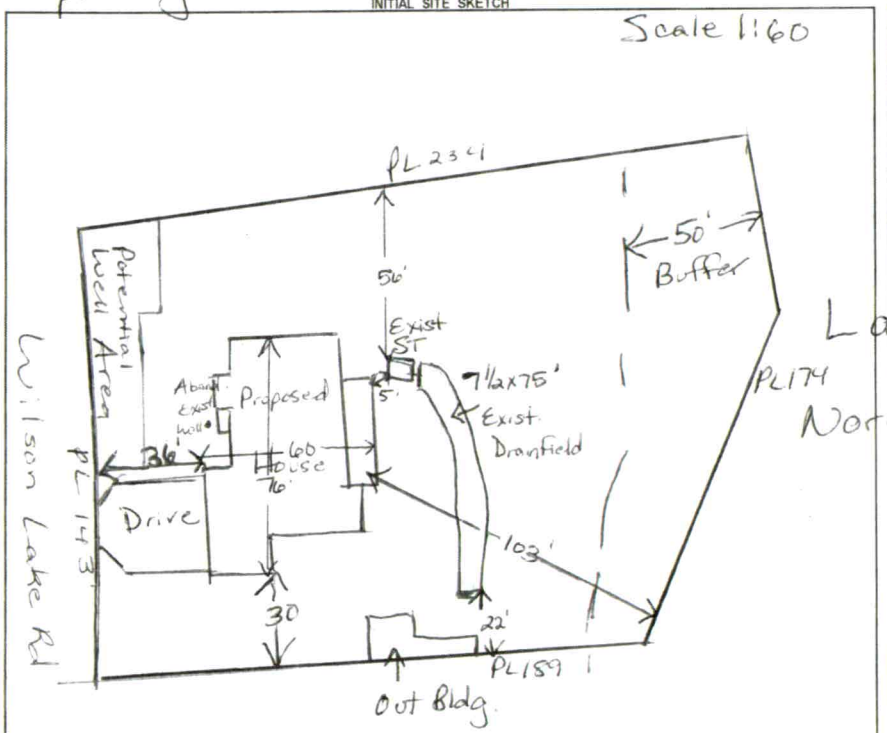

FOR SEPTIC FINAL INSPECTION CALL: 704-664-3703 between 8am-9am the day the inspection is needed. Be sure to speak with an inspector to confirm your time.

Inspection However due to age of ST. the Structural integrity should be looked at.

Permit can be suspended or revoked if any false information is supplied toward securing the permit / any unauthorized changes are made to the site / any unauthorized changes are made in the installation of the system. **CONTACT A LOCATOR SERVICE PRIOR TO ANY EXCAVATION**

☐ **IMPROVEMENT PERMIT** *with plat valid without expiration.* ☒ **IMPROVEMENT PERMIT** *with site plan valid for 60 mos.* ☒ **AUTHORIZATION TO CONSTRUCT** *valid for period equal to IMPROVEMENT PERMIT--not to exceed 60 mo.*

Owner / Applicant Signature: Mary Quinn Hancock Date: 5/9/2022 Installed by: Septic System installed 1967

MENT PERMIT by: Date: OPERATION PERMIT by: Date:

N TO CONSTRUCT by: Maria Dotson Date: 5/6/22 Existing System Inspected by: Maria Dotson Date: 5/6/22

FOR SEPTIC FINAL INSPECTION: CALL 704-664-3703 between 8am-9am the day the inspection is needed.