IREDELL COUNTY HEALTH DEPARTMENT

Statesville Phone TR 3-7271 Mooresville Phone NO 3-1271

PERMIT TO INSTALL SEPTIC TANK

Permit NO. _____ Permit Date 1 July 1965

Owner B. W. Picklesimer Address Charlotte, N.C.

Installed By Clyde Hoke Address Statesville, N.C.


Location of Property Sect. 11 Lot 11

| Tank | | Capacity | | Length of Lines | | Fixtures | |
|---|---|---|---|---|---|---|---|
| Block | ( ) | 800 | ( ) | 150' | ( ) | No. of Baths | ( ) |
| Precast | (✓) | 900 | ( ) | 175' | ( ) | Dishwasher | ( ) |
| | | 1000 | (✓) | 200' | ( ) | Garbage Grdr. | ( ) |
| | | 1100 | ( ) | 225' | (✓) | Auto-Washer | ( ) |
| | | 1200 | ( ) | 250' | ( ) | Other | |
| | | Other | | Other | | | |

NOTIFY HEALTH DEPARTMENT AT LEAST EIGHT HOURS BEFORE TANK IS TO BE INSPECTED.

Final Inspection 1 July 1965 Approved (✓) Disapproved ( )

Remarks _____

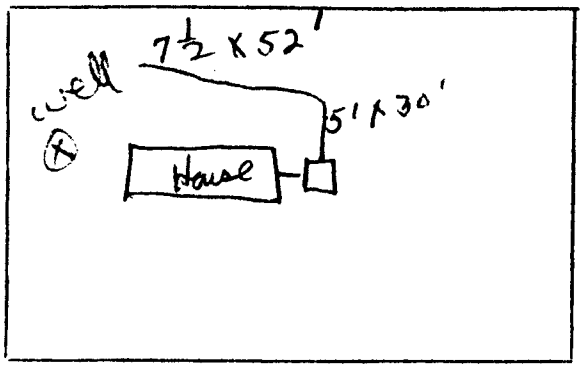


Sketch of Installation

Ray Sessyne RS

Sanitarian