IREDELL COUNTY HEALTH DEPARTMENT

Statesville Phone TR 3-7271 Mooresville Phone NO 3-1271

PERMIT TO INSTALL SEPTIC TANK

Permit NO._____ Permit Date 1 July 1965

Owner B. W. Picklesimer Address Charlotte, NC

Installed By Clyde Hoke Address Statesville, N.C.


Location of Property Sect. 11 Lot 11

Tank		Capacity		Length of Lines		Fixtures	
Block	( )	800	( )	150'	( )	No. of Baths	( )
Precast	(✓)	900	( )	175'	( )	Dishwasher	( )
		1000	(✓)	200'	( )	Garbage Grdr.	( )
		1100	( )	225'	(✓)	Auto-Washer	( )
		1200	( )	250'	( )	Other	
		Other		Other			

NOTIFY HEALTH DEPARTMENT AT LEAST EIGHT HOURS BEFORE TANK IS TO BE INSPECTED.

Final Inspection 1 July 1965 Approved (✓) Disapproved ( )

Remarks

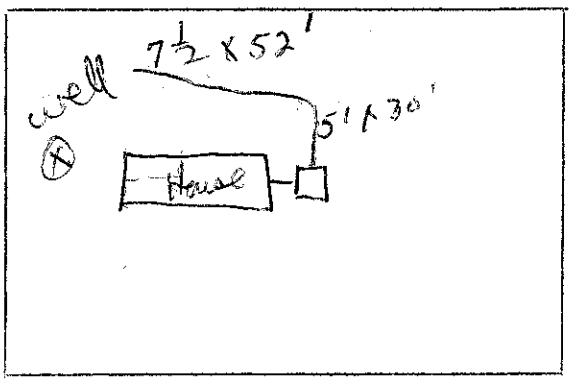

Sketch of Installation

Ray Sergeant RS
Sanitarian

can count system as 3 Bd. if original house was 3 bd.

5' x 30' = 150 ft²

7.5' x 52' = 390

540 ft²

take 2/3 ÷ 1.5 = 360 ft²

÷ 3 = 120' usable linear

to apply towards the current standard for septic systems.

1-16-07 from Steve Hedrick