4638917614

IREDELL COUNTY HEALTH DEPARTMENT

STATESVILLE 704-878-5305 MOORESVILLE 704-664-5281

IMPROVEMENT PERMIT / CERTIFICATE OF COMPLETION / OPERATION PERMIT / EXISTING SYSTEM INSPECTION

PROPERTY DESCRIPTION NO. Repair DATE 3/13/95 TAX MAP NO. Repair Watershed: ☐ Yes ☑ No

OWNER OR CONTRACTOR William Hinson PHONE: Business _____ Home 664-7536

ADDRESS 329 Wilson Lake Rd. Mooresville, NC. 28115

LOCATION Perth Rd; TR on Wilson Lake Rd. on (L) .8 mile

SUBDIVISION ~~NHA~~ CL+T BLOCK / SECTION 11 LOT ~~NHA~~ 12 LOT AREA Existing SITE CLASS. P DESIGN FLOW 360 L.T.A.R. .25

Septic Tank: Existing Gallons; STB _____ Date _____

Pump Tank: _____ Gallons; PT _____ Date _____

Pump Make: _____ Model 1275 Serial No. 340

Nitrification Field: No Fields 1 Square Feet ~~1320~~ Linear Feet ~~110~~

No Lines 4 Trench Width 12' Max Trench Bottom Depth 14" Gravel Depth _____

☐ New System ☑ Repair System Type: (I) II, III, IV, V, VI

System Description: Bed - Gravity

Repair System Description: Pressure - Panel

Maintenance Agreement Required: ☐ Yes ☑ No

☑ House/Mod. Home No. Bedrooms 3

☐ Mobile Home No. Bathrooms 2

☐ Business No. Employees _____

☐ Other _____


☐ Slab ☐ Crawl Space ☐ Basement w/plumbing ☐ Basement wo/plumbing

Water Supply: ☑ Individual ☐ Community ☐ Public

Comments: 300' feet of shoreline can be used. LAKE

Comments: Installed as shown on I.P.

INITIAL SITE SKETCH

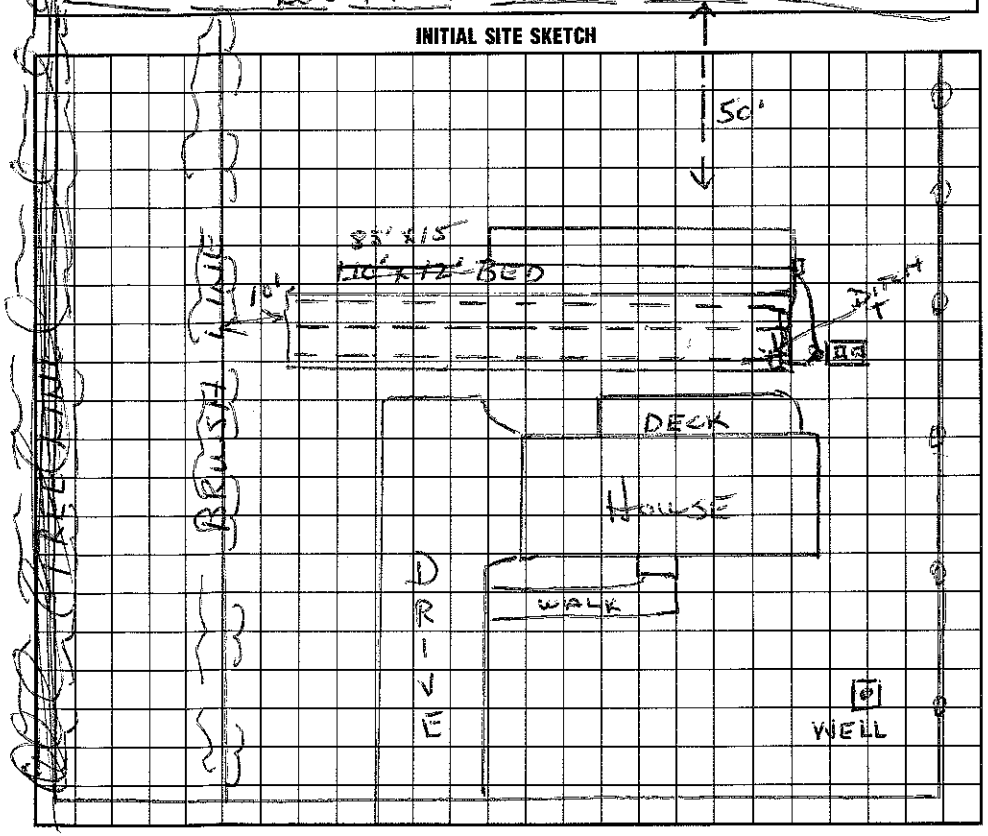

AS BUILT SKETCH

I understand that this permit can be suspended or revoked if any false information is supplied toward securing the permit/any unauthorized changes are made to the site/any unauthorized changes are made in the installation of the system. Improvement Permit is valid for 60 months from date of issuance.

Signed: _____

Improvement Permit by: Wesley Sparks RS. date 3/13/95

Existing System Inspection by: _____ date _____

Installed by: Julian Bowles

Certificate of Completion by: Wesley Sparks RS. date 7/20/95

Operation Permit by: _____ date _____

HEALTH DEPT. COPY: WHITE INSPECTION COPY (FINAL): GREEN OWNER COPY (FINAL): YELLOW INSPECTION COPY (INITIAL): PINK OWNER COPY (INITIAL): GOLD