# IREDELL COUNTY HEALTH DEPARTMENT

STATESVILLE 704-878-5305 MOORESVILLE 704-664-5281

## IMPROVEMENT PERMIT / AUTHORIZATION TO CONSTRUCT / OPERATION PERMIT / EXISTING SYSTEM INSPECTION

PERMIT# 072139 PIN# ~~4639-73-4550 (pt)~~ 4638-95-2919 DATE May 4, '98

OWNER OR CONTRACTOR Stumpy Creek LLC PHONE: Business 633-6124 Home

ADDRESS 614 N. Main St Salisbury, N.C. 28144

LOCATION Park Rd. N. TR Sagemore on left in curve

SUBDIVISION Harbor Landing BLOCK / SECTION II LOT 24 LOT AREA 29,212 ft² SITE CLASS. PS DESIGN FLOW 360gpd L.T.A.R. .25

Septic Tank: 1000 Gallons; STB 312 Date 4/14/98
Pump Tank: ____ Gallons; PT ____ Date ____
Pump Make: ____ Model ____ Serial No. ____
Nitrification Field: No Fields 1 Square Feet 1080 Linear Feet 360
No Lines 5@72' Trench Width 36" Max Trench Bottom Depth ~24" Gravel Depth NA

☑ New System ☐ Repair System Type: I, II, (III), IV, V, VI
System Description: gravity MOD - 25% Red
Repair System Description: ~~PM MOD ON #30A~~ SFE for 24
Maintenance Agreement Required: ☐ Yes ☑ No

☑ House/Mod. Home No. Bedrooms 3
☐ Mobile Home No. Bathrooms 2
☐ Business No. Employees ____
☐ Other ____
☐ Slab ☑ Crawl Space ☐ Basement w/plumbing ☐ Basement wo/plumbing


Water Supply:
☐ Individual
☐ Public
☑ Community

Comments:/Conditions: * ONE inspection/observation report per LATERAL
Remove old Burns/TERRACES


Comments:/Conditions:

1" = 60'

**INITIAL SITE SKETCH**

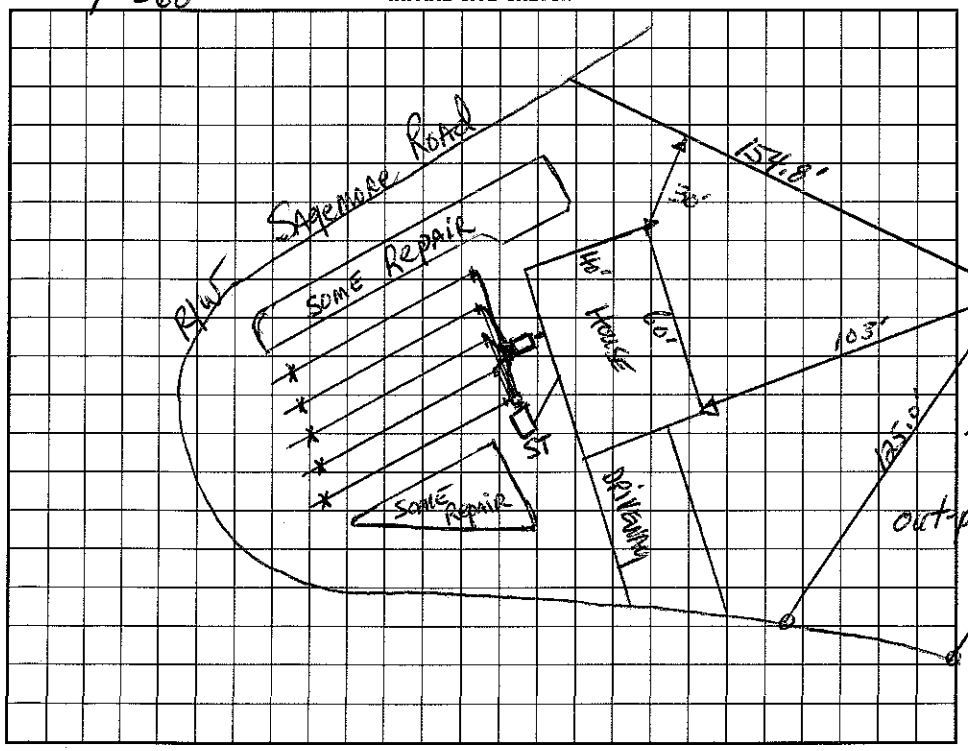


**AS BUILT SKETCH**

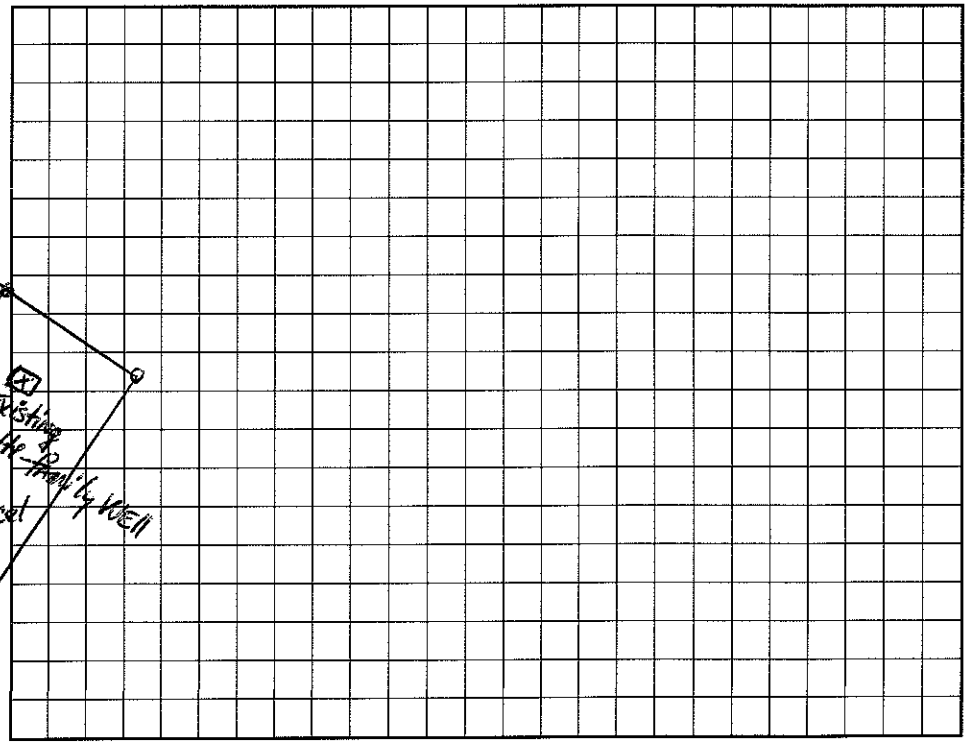


I understand that this permit can be suspended or revoked if any false information is supplied toward securing the permit/any unauthorized changes are made to the site/any unauthorized changes are made in the installation of the system. Improvement Permit with ~~plat~~ valid without expiration. Improvement Permit with site plan valid for sixty months. Authorization to Construct is valid for a period equal to that of Improvement Permit – not to exceed ~~sixty~~ months.

Signed: ____ date 3/5/98 Installed by: Larry Bacon

Improvement Permit by: Daniel Thomas, RS date 5-1-98 Operation Permit by: Wesley Sparks R.S. date 6/21/99

Authorization to Construct by: Wesley Sparks R.S. date 3/30/99 Existing System Inspection by: ____ date ____

HEALTH DEPT. COPY: WHITE INSPECTION COPY (FINAL): GREEN OWNER COPY (FINAL): YELLOW INSPECTION COPY (INITIAL): PINK OWNER COPY (INITIAL): GOLD