11:30-12:00

IREDELL COUNTY HEALTH DEPARTMENT

STATESVILLE 704-878-5305 MOORESVILLE 704-664-5281

IMPROVEMENT PERMIT / AUTHORIZATION TO CONSTRUCT / OPERATION PERMIT / EXISTING SYSTEM INSPECTION

PERMIT# 079863 PIN# 4638953732 DATE 3/31/99

OWNER OR CONTRACTOR LARRY BLACK PHONE: Business _____ Home _____

ADDRESS 510 ST ANDREWS RD STATESVILLE NC 28625

LOCATION PERTH-TR SAGEMORE - .2 MILES ON RT

SUBDIVISION - BLOCK / SECTION - LOT - LOT AREA .75 AC SITE CLASS. 1S DESIGN FLOW 360 L.T.A.R. .3

Septic Tank: 1000 Gallons; STB 312 Date 5/5/99
Pump Tank: _____ Gallons; PT _____ Date _____
Pump Make: _____ Model _____ Serial No. _____
Nitrification Field: No Fields 1 Square Feet 900 Linear Feet 300
No Lines 6@50 Trench Width 36" Max Trench Bottom Depth 36" Gravel Depth N/A

☑ New System ☐ Repair System Type: I II III IV V VI
System Description: GRAVITY CHAMBERS OR EQUIV
Repair System Description: DEEDED B-1 1983
Maintenance Agreement Required: ☐ Yes ☑ No


☑ House/Mod. Home No. Bedrooms 3
☐ Mobile Home No. Bathrooms 3
☐ Business No. Employees ____
☐ Other _____
☐ Slab ☑ Crawl Space ☐ Basement w/plumbing ☐ Basement wo/plumbing

Water Supply: ☑ Individual ☐ Public ☐ Community

Comments:/Conditions: Filter installed.

Comments:/Conditions:

INITIAL SITE SKETCH

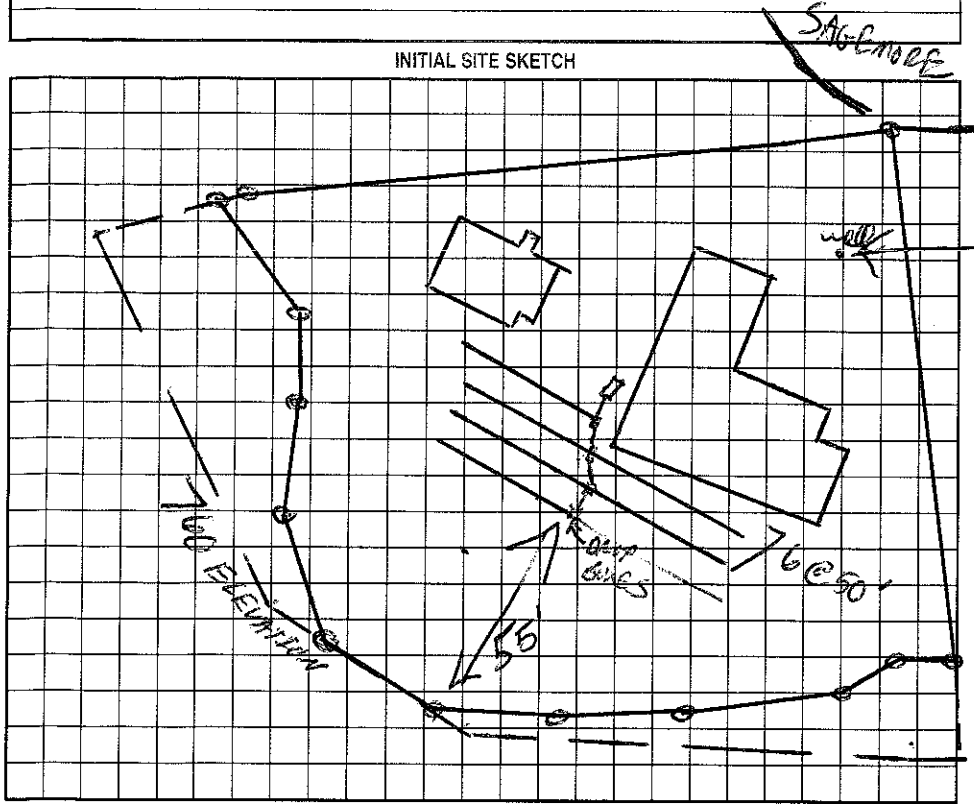

AS BUILT SKETCH

Installed as shown

Permit can be suspended or revoked if any false information is supplied toward securing the permit/any unauthorized changes are made to the site/any unauthorized changes are made in the installation of the system. Improvement Permit with plat valid without expiration. Improvement Permit with site plan valid for sixty months. Authorization to Construct is valid for a period equal to that of Improvement Permit – not to exceed sixty months.

Signed: Larry Black date 4/1/99 Installed by: James Hudler

Improvement Permit by: C. Tyson RS date 3/31/99 Operation Permit by: Maria H. Dotson R.S. date 9/3/99

Authorization to Construct by: C. Tyson RS date 3/31/99 Existing System Inspection by: _____ date _____

HEALTH DEPT. COPY: WHITE OWNER COPY (FINAL): YELLOW OWNER COPY (INITIAL): PINK