4:00

IREDELL COUNTY HEALTH DEPARTMENT

STATESVILLE 704-878-5305 MOORESVILLE 704-664-5281

IMPROVEMENT PERMIT / AUTHORIZATION TO CONSTRUCT / OPERATION PERMIT / EXISTING SYSTEM INSPECTION

PERMIT# 072140 PIN# 4639 73 4530 (pt.) 4638 96 0089 DATE May 4 '98

OWNER OR CONTRACTOR Stumpy Creek LLC // Vasile LAZAR PHONE: Business 633-6124 Home

ADDRESS 614 N. Main Salisbury 152 Sea Trail Dr. Mooresville

LOCATION Perth Rd N. TR Sagemore on left before curve

SUBDIVISION Harbor Landing BLOCK / SECTION II LOT 25 LOT AREA 22860ft² + SFE 28B SITE CLASS. RS DESIGN FLOW 360gpd L.T.A.R. .25 SFE 28B

Septic Tank: 1000 Gallons; STB 825 Date 9-14-00

Pump Tank: 1000 Gallons; PT 302 Date 9-2-00

Pump Make: Hydromatic Model SHEF50 Serial No.

Nitrification Field: No Fields 1 Square Feet 1050+ Linear Feet 350+

No Lines 5@90' Trench Width 36" Max Trench Bottom Depth 30" Gravel Depth NA

☑ New System ☐ Repair System Type: I, II, III, IV, V, VI

System Description: pumped-pm - MOD 75% Red SAME SFE 28B

Repair System Description:

Maintenance Agreement Required: ☐ Yes ☑ No

☑ House/Mod. Home No. Bedrooms 3

☐ Mobile Home No. Bathrooms 2

☐ Business No. Employees

☐ Other


☐ Slab ☑ Crawl Space ☐ Basement w/plumbing ☐ Basement wo/plumbing

Water Supply: ☐ Individual ☐ Public ☑ Community

Comments:/Conditions: * ONE INSPECTION / OBSERVATION PORT PER LATERAL
Remove old Burms / Terraces

Comments:/Conditions: Check tanks & lines 10/13/2000 MD
Didn't install "inspection ports"

1"=100' INITIAL SITE SKETCH

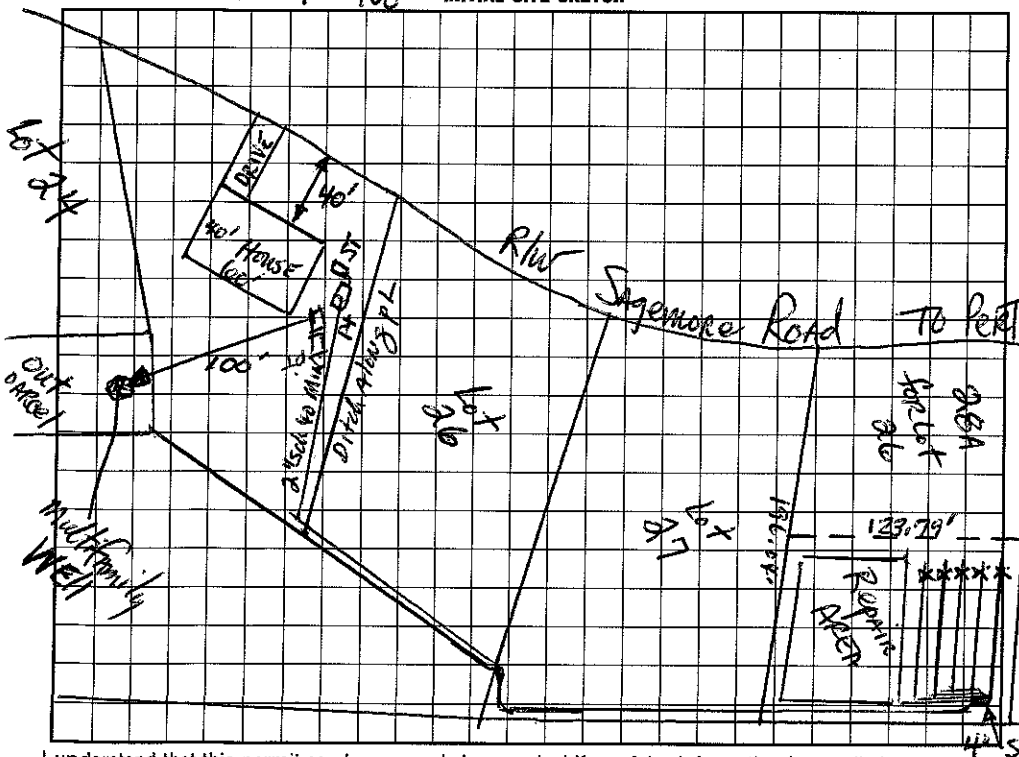

AS BUILT SKETCH

I understand that this permit can be suspended or revoked if any false information is supplied toward securing the permit/any unauthorized changes are made to the site/any unauthorized changes are made in the installation of the system. Improvement Permit with plat valid without expiration. Improvement Permit with site plan valid for sixty months. Authorization to Construct is valid for a period equal to that of Improvement Permit – not to exceed sixty months.

Signed: date 5/5/98 Installed by: Wayne Clontz

Improvement Permit by: Wayne Thompson, RS date 5-4-98 Operation Permit by: Melissa H. Johnson, RS date 10/27/00

Authorization to Construct by: Wayne Thompson, RS date 5-12-00 Existing System Inspection by: date

HEALTH DEPT. COPY: WHITE INSPECTION COPY (FINAL): GREEN OWNER COPY (FINAL): YELLOW INSPECTION COPY (INITIAL): PINK OWNER COPY (INITIAL): GOLD