IREDELL COUNTY HEALTH DEPARTMENT

STATESVILLE 704-878-5305 MOORESVILLE 704-664-5281

IMPROVEMENT PERMIT / AUTHORIZATION TO CONSTRUCT / OPERATION PERMIT / EXISTING SYSTEM INSPECTION

PERMIT# 72132 PIN# ~~4639734550 (PT)~~ 4638-96-0985 DATE 1/3/00

OWNER OR CONTRACTOR LAKEMONT HOMES PHONE: Business 339-7998 Home

ADDRESS PO Box 1463 MATTHEWS NC 28105

LOCATION PERTH RD - TR SAGEMORE - NEAR END ON L

SUBDIVISION HARBOR LANDING BLOCK / SECTION II LOT 17 LOT AREA 34,100ft² SITE CLASS P3 DESIGN FLOW ~~480~~ 360 GPD L.T.A.R. .3 gpd/ft²

Septic Tank: 1000 Gallons; STB 312 Date 9/1/99

Pump Tank: Gallons; PT Date

Pump Make: Model Serial No.

Nitrification Field: No Fields Square Feet 900 Linear Feet 300

No Lines ~~4~~ 3 Trench Width 36" Max Trench Bottom Depth 36" Gravel Depth N/A

☑ New System ☐ Repair System Type: I, II, III, IV, V, VI

System Description: GRAVITY 25% REDUCTION

Repair System Description: PUMP SAME

Maintenance Agreement Required: ☐ Yes ☑ No

☑ House/Mod. Home No. Bedrooms 3

☐ Mobile Home No. Bathrooms 2

☐ Business No. Employees

☐ Other

☐ Slab ☑ Crawl Space ☐ Basement w/plumbing ☐ Basement wo/plumbing


Water Supply: ☐ Individual ☐ Public ☑ Community

Comments:/Conditions:


Comments:/Conditions:

5 at 63' x 3' installed

INITIAL SITE SKETCH 1"=60'

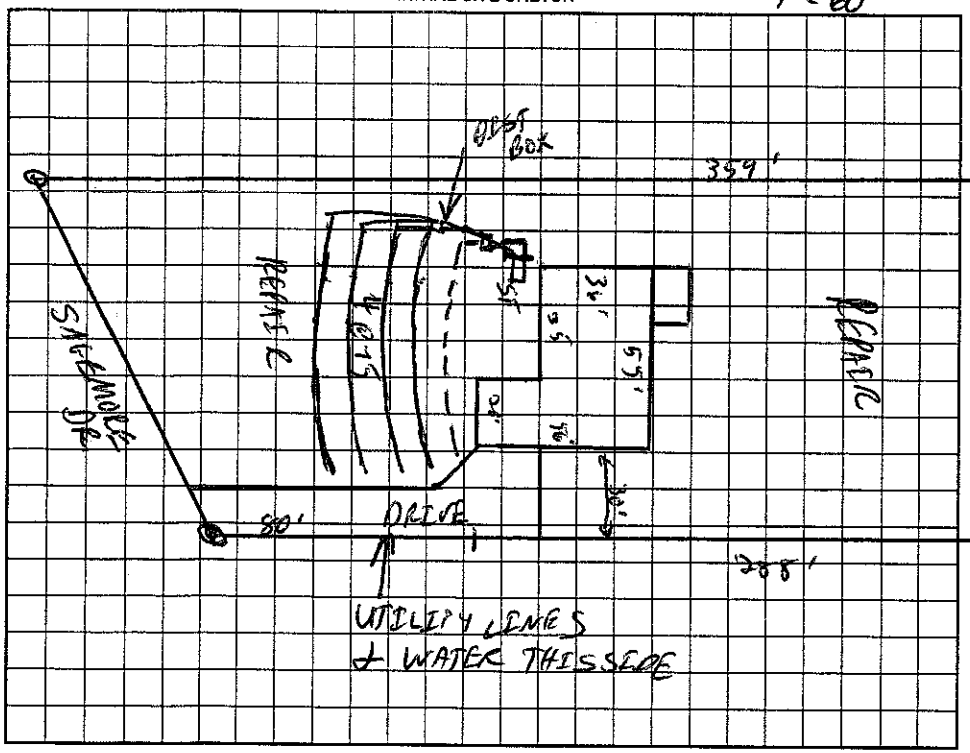

AS BUILT SKETCH

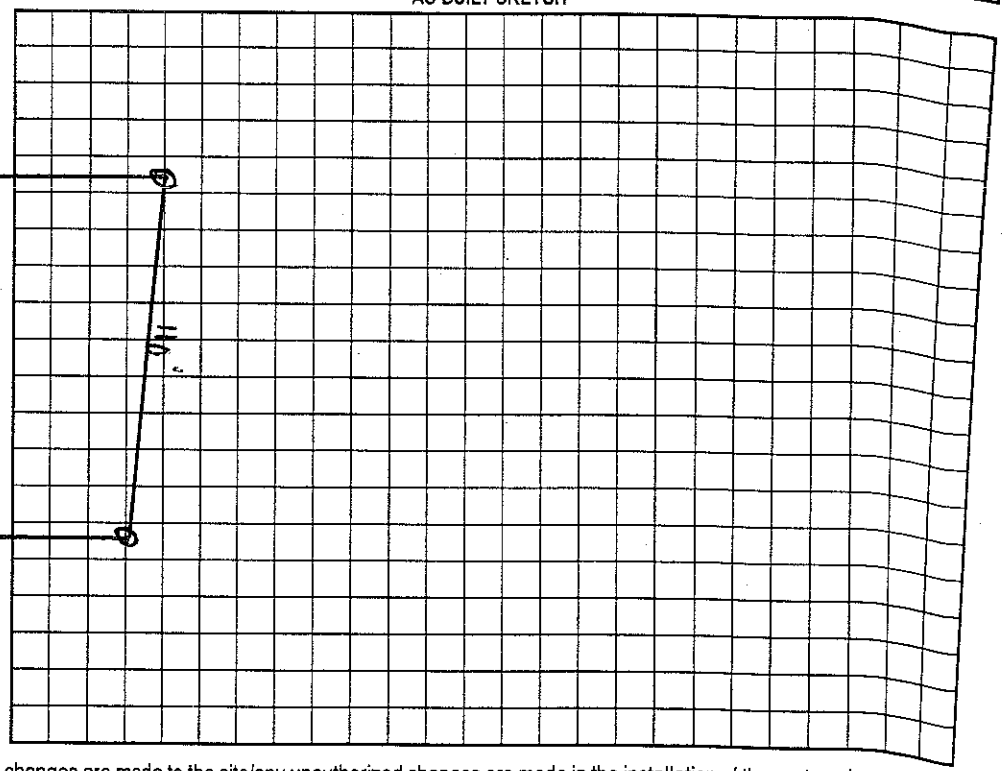

Permit can be suspended or revoked if any false information is supplied toward securing the permit/any unauthorized changes are made to the site/any unauthorized changes are made in the installation of the system. Improvement Permit with plat valid without expiration. Improvement Permit with site plan valid for sixty months. Authorization to Construct is valid for a period equal to that of Improvement Permit – not to exceed sixty months.

Signed: date 1/4/00 Installed by: Larry Beam

Improvement Permit by: RS date 1/3/00 Operation Permit by: Wesley Sparks RS. date 3/22/00

Authorization to Construct by: RS date 1/3/00 Existing System Inspection by: date

HEALTH DEPT. COPY: WHITE OWNER COPY (FINAL): YELLOW OWNER COPY (INITIAL): PINK