(200-2.30)

IREDELL COUNTY HEALTH DEPARTMENT

STATESVILLE 704-878-5305 MOORESVILLE 704-664-5281

IMPROVEMENT PERMIT / AUTHORIZATION TO CONSTRUCT / OPERATION PERMIT / EXISTING SYSTEM INSPECTION

PERMIT# 072138 PIN# 4639 73 4530 (pt) 4638 96 1264 DATE May 4, 98

OWNER OR CONTRACTOR Stumpy Creek LLC / Scott Goodman PHONE: Business 633-6124 Home

ADDRESS 614 N. Main Salisbury 28144

LOCATION Perth Rd N. TR Sagemore round sharp curve on left

SUBDIVISION Harbor Landing BLOCK / SECTION II LOT 23 LOT AREA 26,771+Site 29B SITE CLASS. PS DESIGN FLOW 360gpd L.T.A.R. ~.25

Septic Tank: 1000 Gallons; STB 825 Date 5-1-99
Pump Tank: 1000 Gallons; PT 47 Date 3-21-99
Pump Make: Model Serial No.
Nitrification Field: No Fields 1 Square Feet 1080 Linear Feet 350
No Lines 5@70' Trench Width 36" Trench Bottom Depth 36" Gravel Depth N/A

☑ New System ☐ Repair System Type: I, II, III, IV, V, VI
System Description: pumped pm - MOD 25% Red.
Repair System Description: same
Maintenance Agreement Required: ☐ Yes ☑ No


☑ House/Mod. Home No. Bedrooms 3
☐ Mobile Home No. Bathrooms 2
☐ Business No. Employees
☐ Other
☐ Slab ☑ Crawl Space ☐ Basement w/plumbing ☐ Basement wo/plumbing

Water Supply: ☐ Individual ☐ Public ☑ Community


Comments:/Conditions: * ONE inspection / observation port per LATERAL

Comments:/Conditions:

INITIAL SITE SKETCH 1"=100'

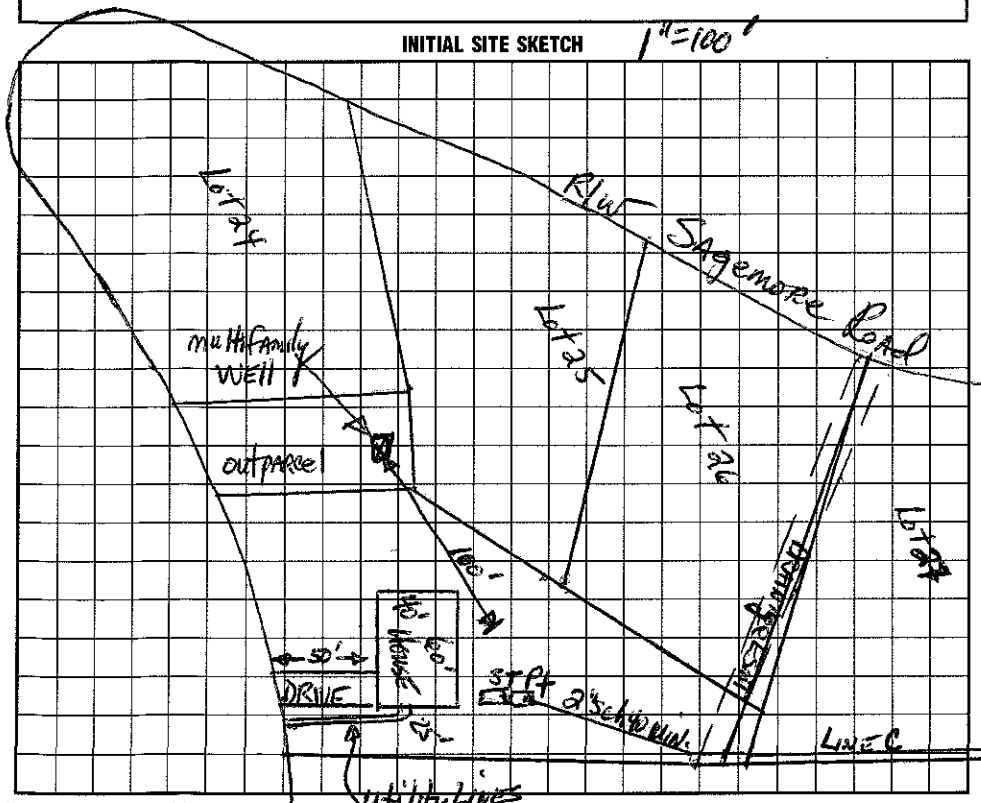

AS BUILT SKETCH

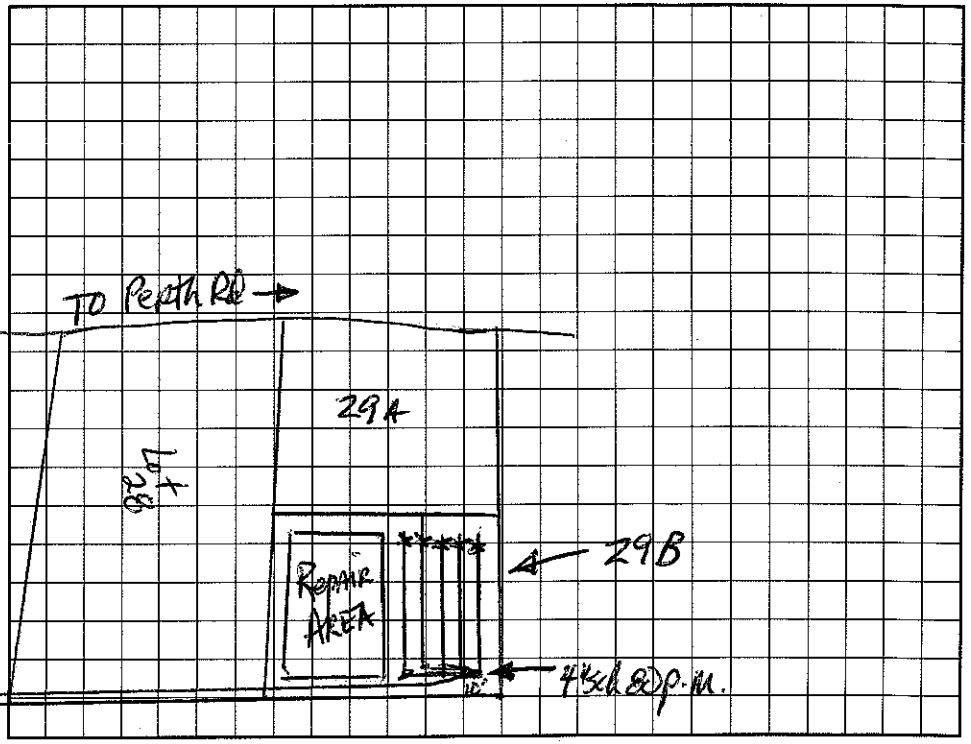

I understand that this permit can be suspended or revoked if any false information is supplied toward securing the permit/any unauthorized changes are made to the site/any unauthorized changes are made in the installation of the system. Improvement Permit with plat valid without expiration. Improvement Permit with site plan valid for sixty months. Authorization to Construct is valid for a period equal to that of Improvement Permit – not to exceed sixty months.

Signed: date 5/5/98 Installed by: Wayne Clontz

Improvement Permit by: date 5-4-98 Operation Permit by: Jeff Morgan date 7/7/99

Authorization to Construct by: date 10-26-98 Existing System Inspection by: date

HEALTH DEPT. COPY: WHITE INSPECTION COPY (FINAL): GREEN OWNER COPY (FINAL): YELLOW INSPECTION COPY (INITIAL): PINK OWNER COPY (INITIAL): GOLD