9-30

IREDELL COUNTY HEALTH DEPARTMENT

STATESVILLE 704-878-5305 MOORESVILLE 704-664-5281

IMPROVEMENT PERMIT / AUTHORIZATION TO CONSTRUCT / OPERATION PERMIT / EXISTING SYSTEM INSPECTION

PERMIT# 072137 PIN# ~~4639-73-4350 Lot 2~~ 4638-96-1387 DATE May 4, '98

OWNER OR CONTRACTOR Stumpy Creek LLC - (Dan Hawks) PHONE: Business _____ Home _____

ADDRESS 614 N. Main / Salisbury / N.C. 28144

LOCATION Peeler Rd. N. TR Sagemore on left

SUBDIVISION Harbor Landing BLOCK / SECTION II LOT 22 LOT AREA 23,427+ SFE#30B SITE CLASS. PS DESIGN FLOW 360gpd L.T.A.R. .25

Septic Tank: 1000 Gallons; STB 794 Date 2/19/99
Pump Tank: _____ Gallons; PT _____ Date _____
Pump Make: _____ Model _____ Serial No. _____
Nitrification Field: No Fields 1 Square Feet 1080 Linear Feet 360
No Lines 5@72' Trench Width 36" Max Trench Bottom Depth ~24" Gravel Depth NA

☑ New System ☐ Repair System Type: I, II, III, IV, V, VI
System Description: 9 variety MOD 25% Reduction
Repair System Description: pm+conv. on #30B
Maintenance Agreement Required: ☐ Yes ☑ No

☑ House/Mod. Home ☐ Mobile Home ☐ Business ☐ Other
No. Bedrooms 3 No. Bathrooms 2 No. Employees _____

☑ Slab ☑ Crawl Space ☐ Basement w/plumbing ☐ Basement wo/plumbing


Water Supply: ☐ Individual ☐ Public ☑ Community

Comments:/Conditions: * ONE INSPECTION/observation port per Lateral
Elevate house pad or increase foundation/crawl space and backfill as needed around house.

Comments:/Conditions:

1"=60'

INITIAL SITE SKETCH

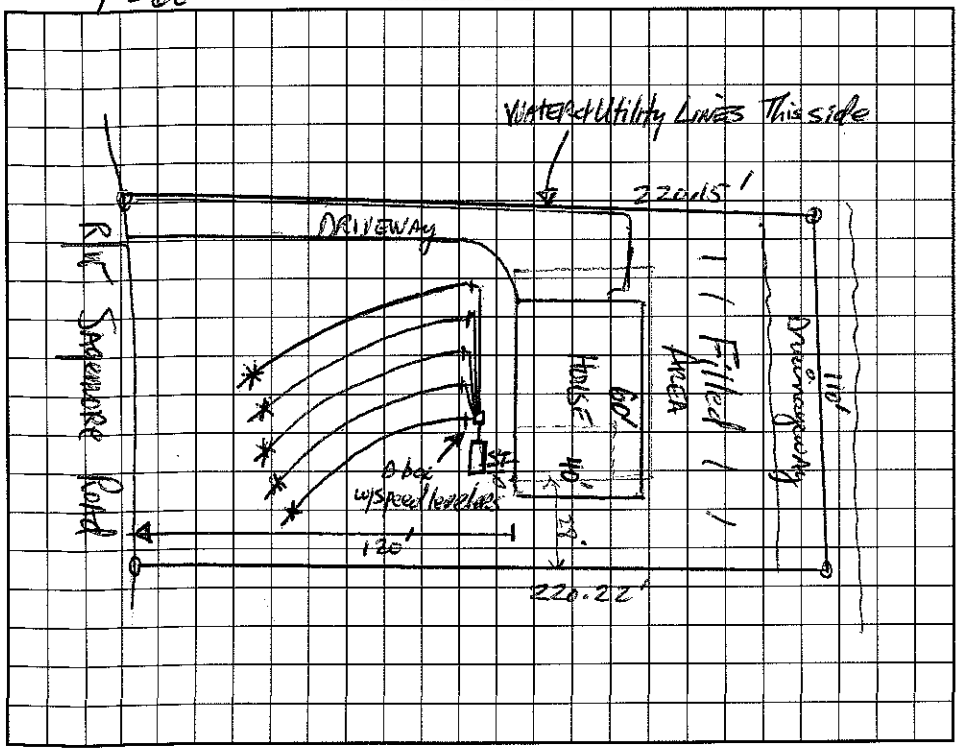

AS BUILT SKETCH

I understand that this permit can be suspended or revoked if any false information is supplied toward securing the permit/any unauthorized changes are made to the site/any unauthorized changes are made in the installation of the system. Improvement Permit with plat valid without expiration. Improvement Permit with site plan valid for sixty months. Authorization to Construct is valid for a period equal to that of Improvement Permit – not to exceed sixty months.

Signed: _____ date 5/5/98 Installed by: Eddie Beam

Improvement Permit by: _____ RS date 5-4-98 Operation Permit by: C. _____ RS date 4/19/99

Authorization to Construct by: Wesley Sparks RS. date 12/21/98 Existing System Inspection by: _____ date _____

HEALTH DEPT. COPY: WHITE INSPECTION COPY (FINAL): GREEN OWNER COPY (FINAL): YELLOW INSPECTION COPY (INITIAL): PINK OWNER COPY (INITIAL): GOLD