ELL COUNTY HEALTH DEPARTMENT

STATESVILLE 704-878-5305 MOORESVILLE 704-664-5281

OVEMENT PERMIT / AUTHORIZATION TO CONSTRUCT / OPERATION PERMIT / EXISTING SYSTEM INSPECTION

.....t# 072135 PIN# 4639 73 4530 (pt) DATE May 1, 198

OWNER OR CONTRACTOR Stumpy Creek LLC / HAUS BUILDERS PHONE: Business 633-6124 Home

ADDRESS 614 N. Main Salisbury N.C. 28144

LOCATION Perth Rd. N. TR Stagemore on left

SUBDIVISION Harbor Landing BLOCK / SECTION II LOT 20 LOT AREA 24,658 ft² SITE CLASS. PS DESIGN FLOW 360gpd L.T.A.R. .025 (with A1)

Septic Tank: 1000 Gallons; STB 31" Date 8/23/02

Pump Tank: Gallons; PT Date

Pump Make: Model Serial No.

Nitrification Field: No Fields 1 Square Feet 1080 Linear Feet 360

No Lines 4@90' Trench Width 36" Max Trench Bottom Depth 24" Gravel Depth NA

☑ New System ☐ Repair System Type: I, II, III, IV, V, VI

System Description: gravity MOD-25% Red.

Repair System Description: gravity pumped MOD-25% Red

Maintenance Agreement Required: ☐ Yes ☑ No 50% Red.

☑ House/Mod. Home No. Bedrooms 3

☐ Mobile Home No. Bathrooms 2

☐ Business No. Employees

☐ Other

☐ Slab ☑ Crawl Space ☐ Basement w/plumbing ☐ Basement wo/plumbing

Water Supply: ☐ Individual ☐ Public ☑ Community

Comments:/Conditions: * ONE INSPECTION / observation port per LATERAL


Remove old Byers / terraces

2-4-03 - OK to install drainfield in 5 lines due to cut of sidestreet - DRH


1"=60'

Comments:/Conditions:

INITIAL SITE SKETCH

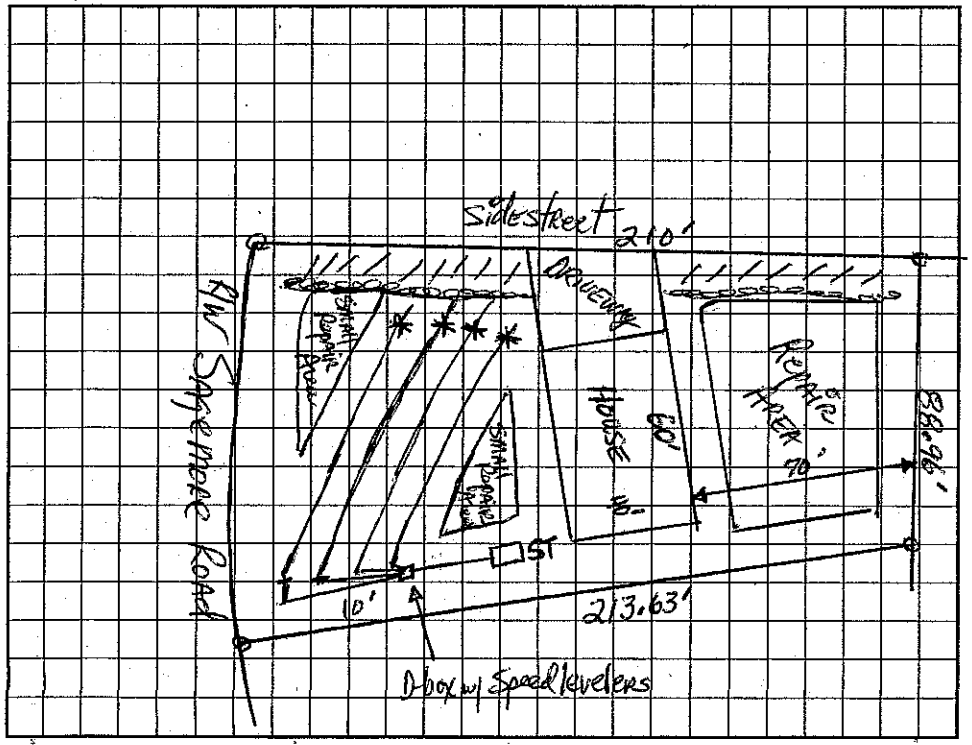

AS BUILT SKETCH

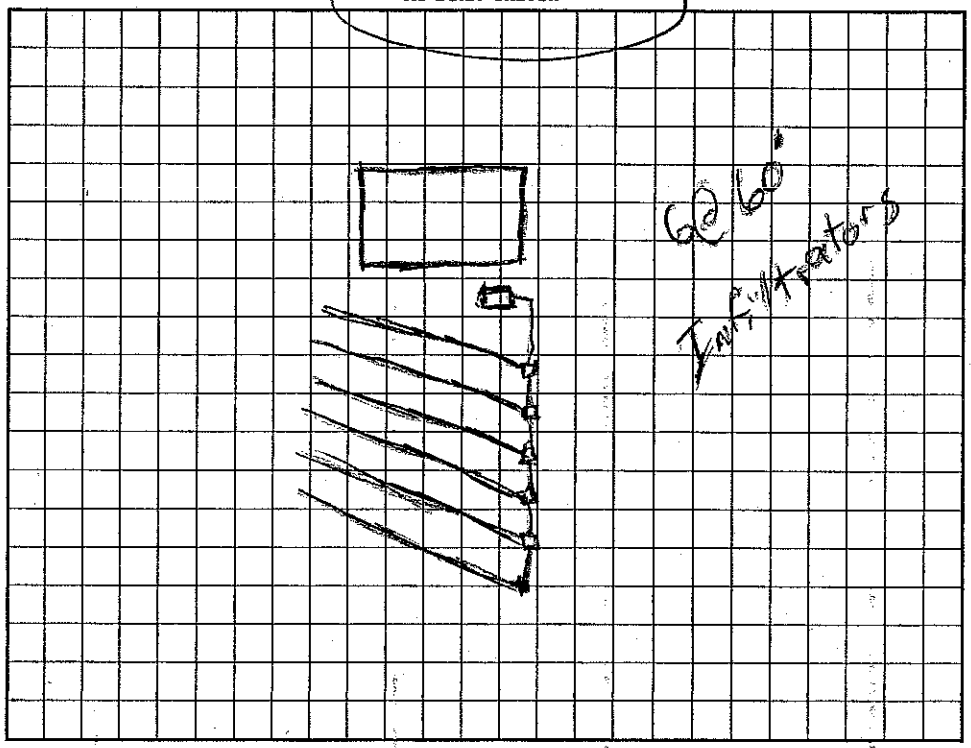

I understand that this permit can be suspended or revoked if any false information is supplied toward securing the permit/any unauthorized changes are made to the site/any unauthorized changes are made in the installation of the system. Improvement Permit with plat valid without expiration. Improvement Permit with site plan valid for sixty months. Authorization to Construct is valid for a period equal to that of Improvement Permit – not to exceed sixty months.

Signed: date 5/5/98 Installed by: Larry Beam

Improvement Permit by: date 5-1-98 Operation Permit by: date 2/5/03

Authorization to Construct by: RS date 9/6/02 Existing System Inspection by: date

HEALTH DEPT. COPY: WHITE INSPECTION COPY (FINAL): GREEN OWNER COPY (FINAL): YELLOW INSPECTION COPY (INITIAL): PINK OWNER COPY (INITIAL): GOLD