IREDELL COUNTY HEALTH DEPARTMENT

STATESVILLE 704-878-5305 MOORESVILLE 704-664-5281

IMPROVEMENT PERMIT / AUTHORIZATION TO CONSTRUCT / OPERATION PERMIT / EXISTING SYSTEM INSPECTION

DATE May 1, '98

PERMIT# 072133 PIN# ~~4639 73 4550 (pt.)~~ 4638-96-2816

OWNER OR CONTRACTOR Stumpy Creek LLC PHONE: Business 633-6124 Home

ADDRESS 614 N. Main St Salisbury

LOCATION Perth Rd N. TR Sagemore on left NEAR/AT End

SUBDIVISION Harbor Landing BLOCK / SECTION II LOT 18 LOT AREA 22,203 SITE CLASS. PS DESIGN FLOW 360 gpd L.T.A.R. .3

Septic Tank: 1000 Gallons; STB 825 Date 9/17/98

Pump Tank: Gallons; PT Date

Pump Make: Model Serial No.

Nitrification Field: No Fields 1 Square Feet 900 Linear Feet 300

No Lines 4@75' Trench Width 36" Max Trench Bottom Depth 24"

☑ New System ☐ Repair System Type: I, II, (III) IV, V, VI

System Description: gravity MOD - 25% Red.

Repair System Description: gravel/stamped panel/block

Maintenance Agreement Required: ☐ Yes ☑ No

Gravel Depth NA

☐ Slab ☑ Crawl Space ☐ Basement w/plumbing ☐ Basement wo/plumbing

☑ House/Mod. Home No. Bedrooms 3

☐ Mobile Home No. Bathrooms 2

☐ Business No. Employees

☐ Other

Water Supply: ☐ Individual ☐ Public ☑ Community


Comments:/Conditions: ONE INSPECTION / observation port per Lateral

Remove old Berms / terraces

Comments:/Conditions:

1" = 60'

INITIAL SITE SKETCH

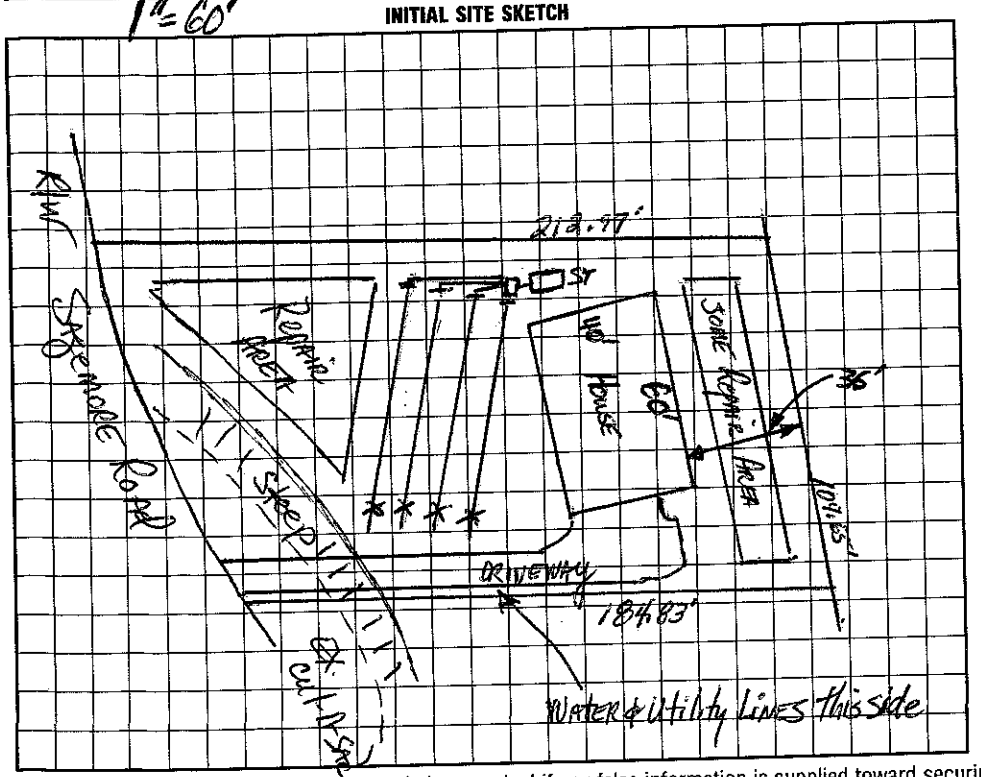

AS BUILT SKETCH

I understand that this permit can be suspended or revoked if any false information is supplied toward securing the permit/any unauthorized changes are made to the site/any unauthorized changes are made in the installation of the system. Improvement Permit with site plan valid for sixty months. Authorization to Construct is valid for a period equal to that of Improvement Permit -- not to exceed sixty months.

Issued: date 5/5/98 Installed by: Rowan Septic

Permit by: date 5-1-98 Operation Permit by: Wesley Sparks RS date 11/9/98

Construct by: date 7/21/98 Existing System Inspection by: date

WHITE COPY: WHITE INSPECTION COPY (FINAL): GREEN OWNER COPY (FINAL): YELLOW INSPECTION COPY (INITIAL): PINK OWNER COPY (INITIAL): GOLD