(3.30)

# IREDELL COUNTY HEALTH DEPARTMENT

STATESVILLE 704-878-5305 MOORESVILLE 704-664-5281

## IMPROVEMENT PERMIT / AUTHORIZATION TO CONSTRUCT / OPERATION PERMIT / EXISTING SYSTEM INSPECT

PERMIT# 072131 PIN# 4639 73 4550 (pt.) 4638 97 0035 DATE April 29, 98

OWNER OR CONTRACTOR Stumpy Creek LLC PHONE: Business 633-6124 Home

ADDRESS 614 N. MAIN ST Salisbury N.C. 28144

LOCATION Perth Rd. N. TR Sagemore AT END ON left

SUBDIVISION Harbor Landing BLOCK / SECTION II LOT 16 LOT AREA 26,058 SITE CLASS. PS DESIGN FLOW 360 gpd L.T.A.R. .3

Septic Tank: 1000 Gallons; STB 825 Date 8/6/98
Pump Tank: 1000 Gallons; PT 47 Date 11/24/98
Pump Make: ZOELLER Model SR 50 Serial No.
Nitrification Field: No Fields 1 Square Feet 900 Linear Feet 300
No Lines 4@75' Trench Width 36" Max Trench Bottom Depth 24" Gravel Depth NA

☑ New System ☐ Repair System Type: I, II, III, IV, V, VI.
System Description: pm - MOD - 25% Reduction
Repair System Description: LP MOD - 25% Red.
Maintenance Agreement Required: ☐ Yes ☒ No initially
☐ Slab ☑ Crawl Space ☐ Basement w/plumbing ☐ Basement wo/plumbing

☑ House/Mod. Home No. Bedrooms 3
☐ Mobile Home No. Bathrooms 2
☐ Business No. Employees
☐ Other

Water Supply:
☐ Individual
☐ Public
☑ Community


Comments:/Conditions: * ONE inspection / observation port per LATERAL

Remove old Burms / terraces


Comments:/Conditions:

1" = 60'

INITIAL SITE SKETCH

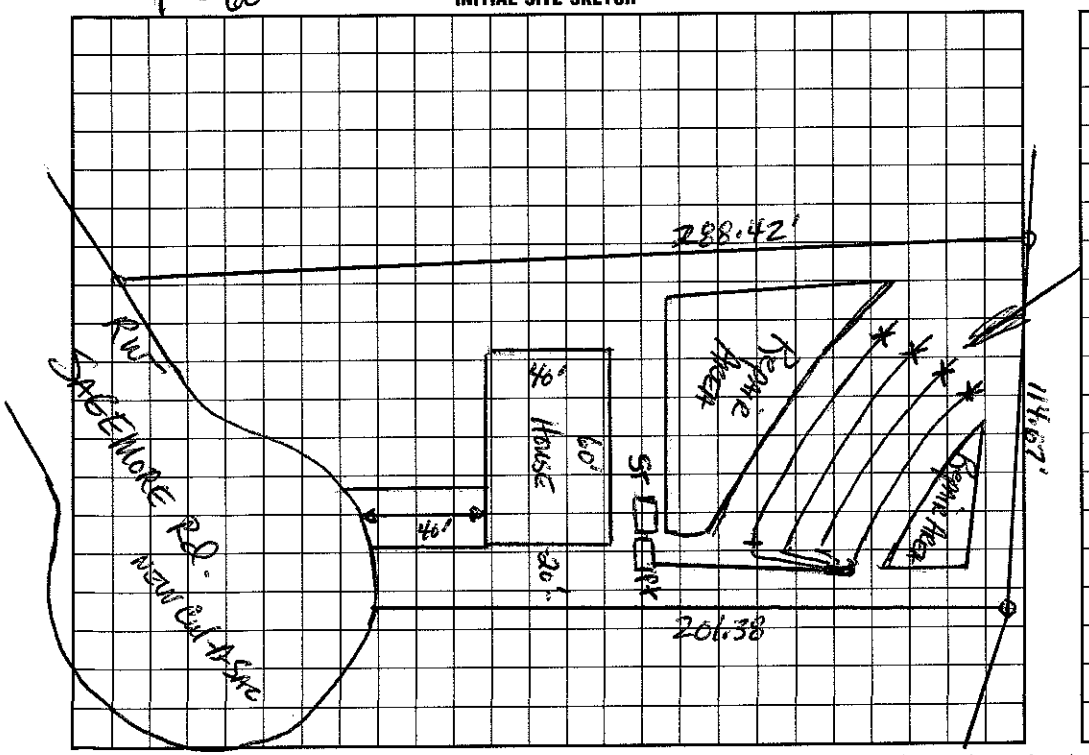


AS BUILT SKETCH

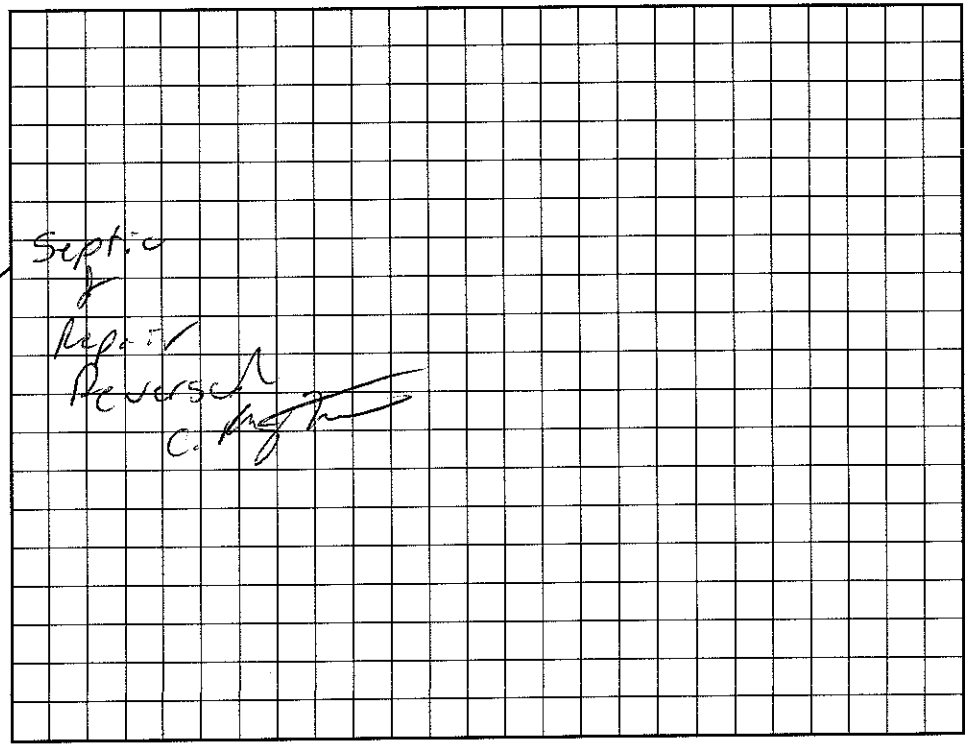


I understand that this permit can be suspended or revoked if any false information is supplied toward securing the permit/any unauthorized changes are made to the site/any unauthorized changes are made in the installation of the system. Improvement Permit with plat valid without expiration. Improvement Permit with site plan valid for sixty months. Authorization to Construct is valid for a period equal to that of Improvement Permit – not to exceed sixty months.

Signed: date 5/5/97 Installed by: ROWAN SEPTIC

Improvement Permit by: date 4-29-98 Operation Permit by: date 3/8/99

Authorization to Construct by: date 7/21/98 Existing System Inspection by: date

HEALTH DEPT. COPY: WHITE INSPECTION COPY (FINAL): GREEN OWNER COPY (FINAL): YELLOW INSPECTION COPY (INITIAL): PINK OWNER COPY (INITIAL): GOLD