...COUNTY HEALTH DEPARTMENT

STATESVILLE 704-878-5305 MOORESVILLE 704-664-5281

...EMENT PERMIT / AUTHORIZATION TO CONSTRUCT / OPERATION PERMIT / EXISTING SYSTEM INSPECTION

072130 PIN# 4639 73 4550 (pt) 4638 97 0119 DATE May 4 98

...OR CONTRACTOR Stumpy Creek LLC PHONE: Business 633-6124 Home

...DRESS 614 N. Main St Salisbury N.C 28144

LOCATION South RD N. to Sagemore Rd. ATEND

SUBDIVISION Harbor Landing BLOCK / SECTION II LOT 15 LOT AREA 39,559 ft² SITE CLASS. PS DESIGN FLOW 360gpd L.T.A.R. .03

Septic Tank: 1000 Gallons; STB 825 Date 10/17/98

Pump Tank: 1000 Gallons; PT 47 Date 12/98

Pump Make: Dould Model N98-C Serial No.

Nitrification Field: No Fields 1 Square Feet 900 Linear Feet 300

No Lines 3@100 Trench Width 36" Max Trench Bottom Depth 36" Gravel Depth NA

☑ New System ☐ Repair System Type: I, II, ☑ IV, V, VI

System Description: pumped-pm-MOD-25% Red.

Repair System Description: LPMOD / Panel Block

Maintenance Agreement Required: ☐ Yes ☐ No

☑ House/Mod. Home No. Bedrooms 3

☐ Mobile Home No. Bathrooms 2

☐ Business No. Employees

☐ Other


☐ Slab ☑ Crawl Space ☐ Basement w/plumbing ☐ Basement wo/plumbing

Water Supply: ☐ Individual ☐ Public ☑ Community

Comments:/Conditions: * ONE INSpection/observation port per LATERAL
7-27-98 - Lot line changed to reflect Easement to be permanent part of Lot 14

Comments:/Conditions:

INITIAL SITE SKETCH

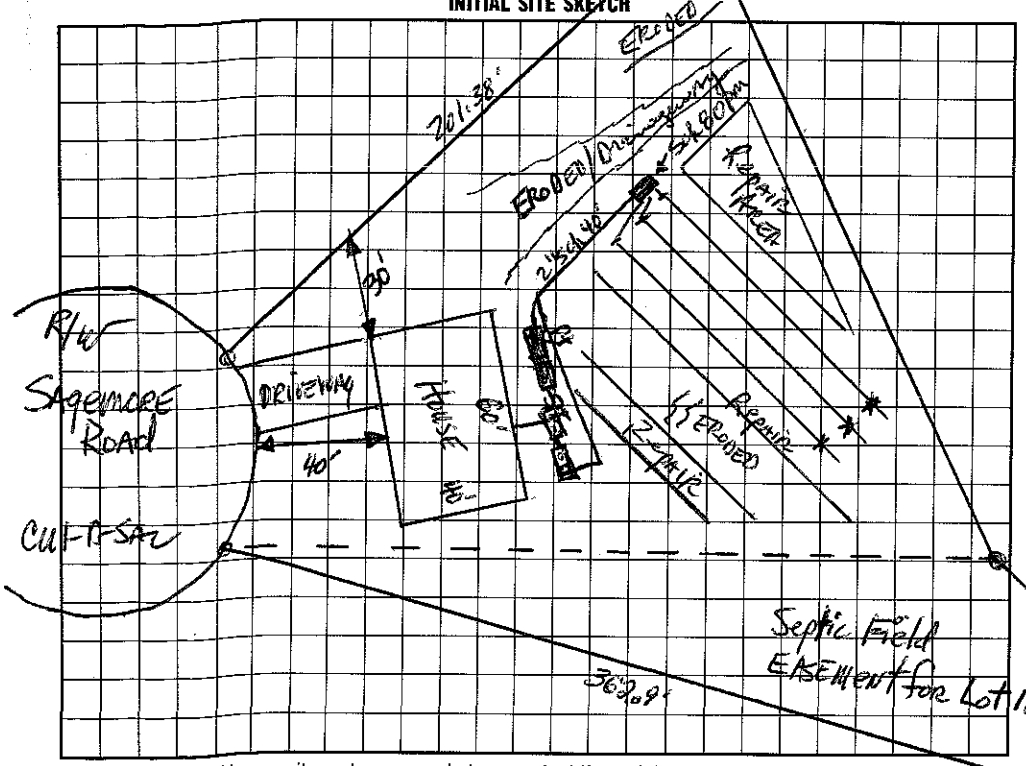

AS BUILT SKETCH

I understand that this permit can be suspended or revoked if any false information is supplied toward securing the permit/any unauthorized changes are made to the site/any unauthorized changes are made in the installation of the system. Improvement Permit with plat valid without expiration. Improvement Permit with site plan valid for sixty months. Authorization to Construct is valid for a period equal to that of Improvement Permit – not to exceed sixty months.

Signed: _____ date 5/5/98

Improvement Permit by: _____ date 5-4-98

...nstruct by: _____ date 7-27-98

Installed by: Rowan Septic Tank

Operation Permit by: _____ date 3/8/99

Existing System Inspection by: _____ date _____

...WHITE INSPECTION COPY (FINAL): GREEN OWNER COPY (FINAL): YELLOW INSPECTION COPY (INITIAL): PINK OWNER COPY (INITIAL): GOLD