# IREDELL COUNTY HEALTH DEPARTMENT

STATESVILLE 704-878-5305 MOORESVILLE 704-664-5281

## IMPROVEMENT PERMIT / CERTIFICATE OF COMPLETION / OPERATION PERMIT / EXISTING SYSTEM INSPECTION

PROPERTY DESCRIPTION NO. 20122 DATE March 26, '95 TAX MAP NO. part of 2545 Watershed: ☑ Yes ☐ No

OWNER OR CONTRACTOR Rowan Financial Services PHONE: Business 664-3671 ~~Home~~ 4638-97-2933 WS-IV

ADDRESS 9 Yacht Cove Rd. Mooresville, N.C.

LOCATION Cornelius Road 7th lot on Right after crossing lake @ Mello Joint West section

SUBDIVISION Mills Joint West BLOCK / SECTION ____ LOT 7 LOT AREA .63 Ac SITE CLASS. PS DESIGN FLOW 360 gpd L.T.A.R. .3

Septic Tank: 1000 Gallons; STB 825 Date 1-5-96

Pump Tank: ____ Gallons; PT ____ Date ____

Pump Make: ____ Model ____ Serial No. ____

Nitrification Field: No Fields 1 Square Feet 1200 Linear Feet 400

No Lines 4 Trench Width 36" Max Trench Bottom Depth 36" Gravel Depth 12"

☑ New System ☐ Repair System Type: I, II, III, IV, V, VI

System Description: gravity conventional

Repair System Description: ____

Maintenance Agreement Required: ☐ Yes ☑ No

☑ House/Mod. Home No. Bedrooms 3

☐ Mobile Home No. Bathrooms 2

☐ Business No. Employees ____

☐ Other ____


☐ Slab ☑ Crawl Space ☐ Basement w/plumbing ☐ Basement wo/plumbing

Water Supply: ☑ Individual ☐ Community ☐ Public

Comments: Exit plumbing at ex grade where shown.

Comments: Ready to close

**INITIAL SITE SKETCH**

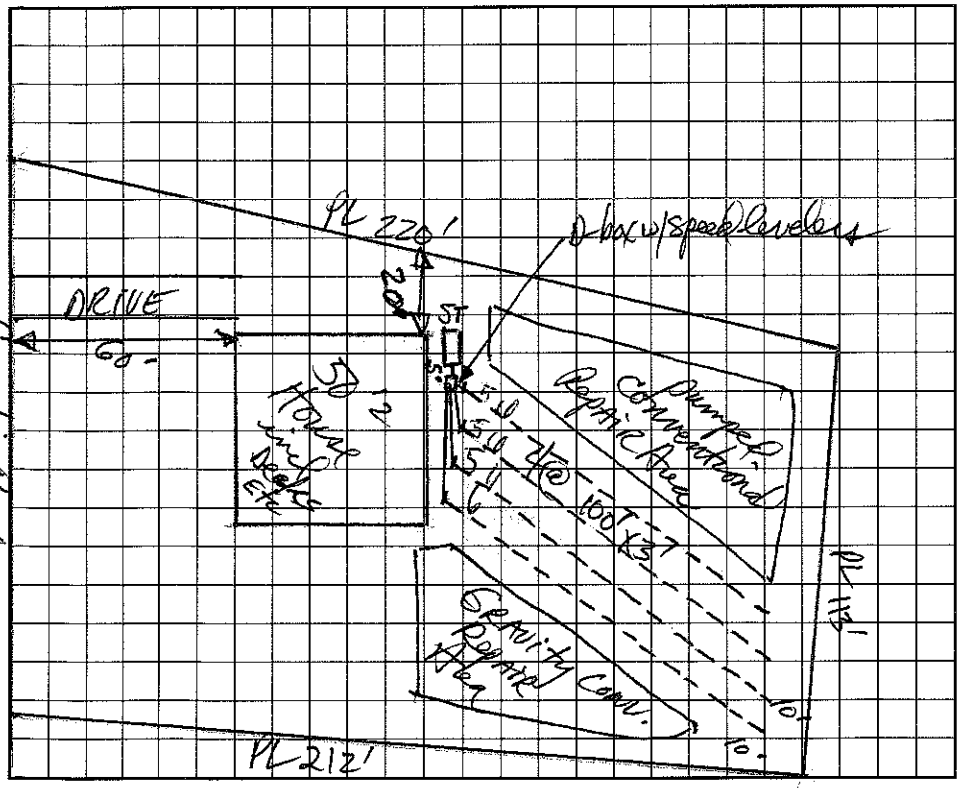


**AS BUILT SKETCH**

I understand that this permit can be suspended or revoked if any false information is supplied toward securing the permit/any unauthorized changes are made to the site/any unauthorized changes are made in the installation of the system. Improvement Permit is valid for 60 months from date of issuance.

Signed: ____ Washington Hardy RS 7/15/95

Improvement Permit by: ____ date 3/26/95

Existing System Inspection by: ____ date ____

Installed by: Rowan Septic

Certificate of Completion by: ____ date ____

Operation Permit by: C. Brady Thomas EHSI date 5/23/96

HEALTH DEPT. COPY: WHITE INSPECTION COPY (FINAL): GREEN OWNER COPY (FINAL): YELLOW INSPECTION COPY (INITIAL): PINK OWNER COPY (INITIAL): GOLD