IREDELL COUNTY HEALTH DEPARTMENT

STATESVILLE 704-878-5305 MOORESVILLE 704-664-5281

IMPROVEMENT PERMIT / CERTIFICATE OF COMPLETION / OPERATION PERMIT / EXISTING SYSTEM INSPECTION

PROPERTY DESCRIPTION NO. 20121 DATE 10/24/95 TAX MAP NO. part of 25 A51 Watershed: X Yes ☐ No

OWNER OR CONTRACTOR Krom Financial Svcs. PHONE: Business 664 3671 Home

ADDRESS 19 Yacht Cove Rd Mooresville, NC 28115

LOCATION Cornelius Rd. 6th on (R) after crossing lake 4638-97-3812

SUBDIVISION Mills Forest West BLOCK / SECTION LOT 6 LOT AREA 1.66AC SITE CLASS. PS DESIGN FLOW 360 L.T.A.R. 1.3

Septic Tank: 1000 Gallons; STB 925 Date 5/16/95

Pump Tank: Gallons; PT Date

Pump Make: Model Serial No.

Nitrification Field: No Fields 1 Square Feet 1200 Linear Feet 400

No Lines 4 Trench Width 36" Max Trench Bottom Depth 36" Gravel Depth 12"

X New System ☐ Repair System Type: I (II) III, IV, V, VI

System Description: gravity conventional

Repair System Description:

Maintenance Agreement Required: ☐ Yes ☐ No

X House/Mod. Home No. Bedrooms 3

☐ Mobile Home No. Bathrooms 2

☐ Business No. Employees

☐ Other


☐ Slab ☐ Crawl Space ☐ Basement w/plumbing ☐ Basement wo/plumbing

Water Supply:
X Individual
☐ Community
☐ Public

Comments:

T-6.5
T-5.5
T-10.5
8-6

SITE SKETCH / AS BUILT

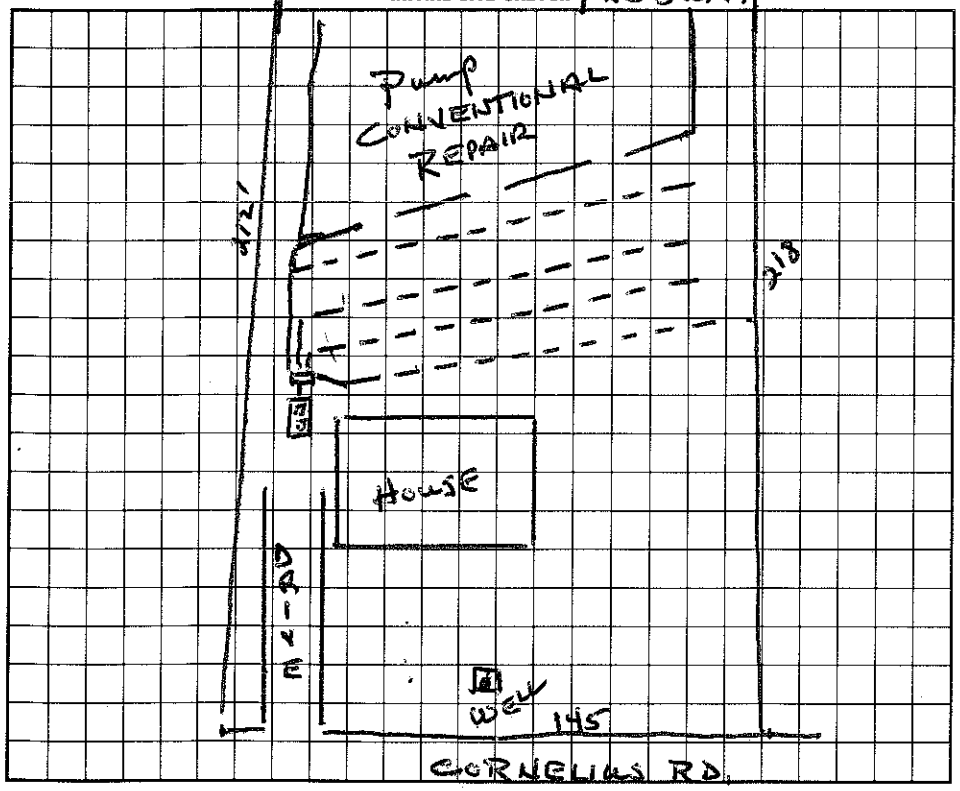

Comments:

AS BUILT SKETCH

I understand that this permit can be suspended or revoked if any false information is supplied toward securing the permit/any unauthorized changes are made to the site/any unauthorized changes are made in the installation of the system.

Signed:

Installed by: Rowan Septic Tank

Improvement Permit by: date

Certificate of Completion by: date

Existing System Inspection by: Construct Wesley Sparks date 10/24/95

Operation Permit by: Wesley Sparks RS date 10/24/95

HEALTH DEPT. COPY: WHITE INSPECTION COPY (FINAL): GREEN OWNER COPY (FINAL): YELLOW INSPECTION COPY (INITIAL): PINK OWNER COPY (INITIAL): GOLD