IREDELL COUNTY HEALTH DEPARTMENT

STATESVILLE 704-878-5305 MOORESVILLE 704-664-5281

IMPROVEMENT PERMIT / CERTIFICATE OF COMPLETION / OPERATION PERMIT / EXISTING SYSTEM INSPECTION

PROPERTY DESCRIPTION NO. 20170 DATE March 26 95 TAX MAP NO. part of 2SA51 Watershed: ☑ Yes ☐ No

OWNER OR CONTRACTOR Kron Financial Services PHONE: Business 664-3671 ~~Home~~ 463-87-4714 INSTV

ADDRESS 19 Yacht Rd. Mooresville

LOCATION Cornelius Road 5th lot on Right after crossing lake at Mills Forest West Section

SUBDIVISION Mills Forest West BLOCK / SECTION _____ LOT 5 LOT AREA .66Ac SITE CLASS. PS DESIGN FLOW 360gpd L.T.A.R. #3

Septic Tank: 1000 Pond Gallons; STB 825 Date 8/16/95

Pump Tank: _____ Gallons; PT _____ Date _____

Pump Make: _____ Model _____ Serial No. _____

Nitrification Field: No Fields 1 Square Feet 1200 Linear Feet 400

No Lines 4 Trench Width 36" Max Trench Bottom Depth 36" Gravel Depth 12"

☑ New System ☐ Repair System Type: I, II, III, IV, V, VI

System Description: Gravity, Conventional

Repair System Description: grav/pump conv.

Maintenance Agreement Required: ☐ Yes ☑ No

☑ House/Mod. Home No. Bedrooms 3

☐ Mobile Home No. Bathrooms 2

☐ Business No. Employees ____

☐ Other _____


☐ Slab ☑ Crawl Space ☐ Basement w/plumbing ☐ Basement wo/plumbing

Water Supply: ☑ Individual ☐ Community ☐ Public

Comments: Exst plumbing at EX grade where shown.

Comments: [redacted] Install as shown on stamp Permit

INITIAL SITE SKETCH

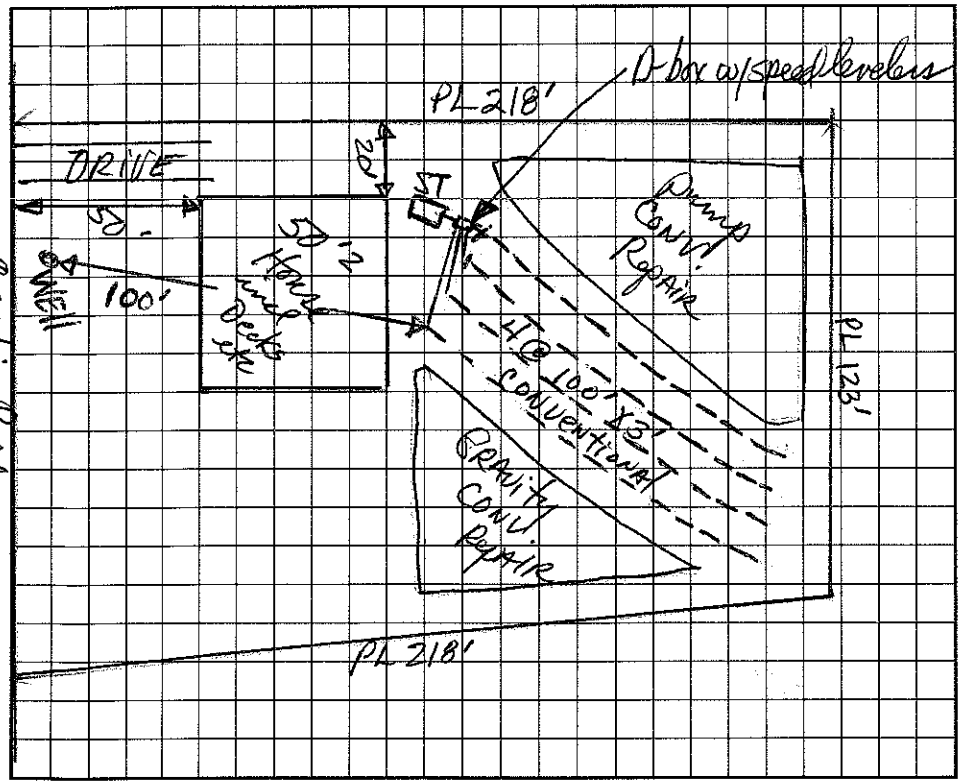

AS BUILT SKETCH

I understand that this permit can be suspended or revoked if any false information is supplied toward securing the permit/any unauthorized changes are made to the site/any unauthorized changes are made in the installation of the system. Improvement Permit is valid for 60 months from date of issuance.

Signed: _____ Wesley Sparks RS 9/14/95

Improvement Permit by: _____ date 3/26/95

Existing System Inspection by: _____ date _____

Installed by: Rowen Septic Tank

Certificate of Completion by: Wesley Sparks RS. date 11/16/95

Operation Permit by: Wesley Sparks RS. date 11/16/95

HEALTH DEPT. COPY: WHITE INSPECTION COPY (FINAL): GREEN OWNER COPY (FINAL): YELLOW INSPECTION COPY (INITIAL): PINK OWNER COPY (INITIAL): GOLD