IREDELL COUNTY HEALTH DEPARTMENT

STATESVILLE 704-878-5305 MOORESVILLE 704-664-5281

IMPROVEMENT PERMIT / CERTIFICATE OF COMPLETION / OPERATION PERMIT / EXISTING SYSTEM INSPECTION

PROPERTY DESCRIPTION NO. 20130 DATE March 30, '95 TAX MAP NO. part of 2545 1 Watershed: ☑ Yes ☐ No

OWNER OR CONTRACTOR Avon Financial Services PHONE: Business 664-3671 Home 438-97-4996 LWW

ADDRESS 19 Yacht Cove Rd, Mooresville

LOCATION Potts Rd TR Cornelius Rd TR Mills West Rd. 6th lot on Right

SUBDIVISION Mills Forest West BLOCK / SECTION ____ LOT 15 LOT AREA .61ac SITE CLASS. B DESIGN FLOW 360gpd L.T.A.R. .03

Septic Tank: 1000 Gallons; STB 825 Date 2/21/95 ☑ New System ☐ Repair System Type: I, II, III, IV, V, VI

Pump Tank: ____ Gallons; PT ____ Date ____ System Description: gravity conventional

Pump Make: ____ Model ____ Serial No. ____ Repair System Description: same

Nitrification Field: No Fields 1 Square Feet 1200 Linear Feet 400 Maintenance Agreement Required: ☐ Yes ☑ No

No Lines 4 Trench Width 36" Max Trench Bottom Depth 36" Gravel Depth 12"

☑ House/Mod. Home No. Bedrooms 3

☐ Mobile Home No. Bathrooms 2

☐ Business No. Employees ____

☐ Other ____

☐ Slab ☑ Crawl Space ☐ Basement w/plumbing ☐ Basement wo/plumbing

Water Supply: ☑ Individual ☐ Community ☐ Public

Comments: Exit plumbing at ex grade where shown.


Comments: Ready to Release 6/15/95 AWS

RELEASED PERMIT

Installed as shown on Imp. Permit

INITIAL SITE SKETCH

1" = 50'

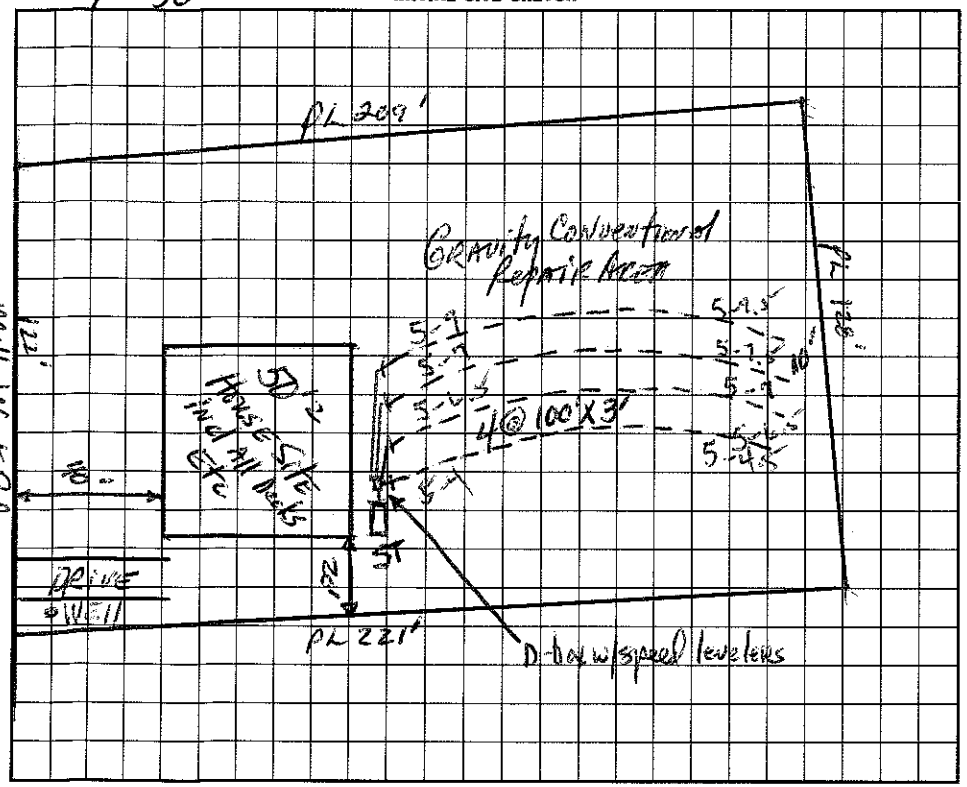

AS BUILT SKETCH

I understand that this permit can be suspended or revoked if any false information is supplied toward securing the permit/any unauthorized changes are made to the site/any unauthorized changes are made in the installation of the system. Improvement Permit is valid for 60 months from date of issuance.

Signed: [signature] AWS 6/15/95

Improvement Permit by: [signature] RS date 3/30/95

Existing System Inspection by: ____ date ____

Installed by: Rowan Septic Tank

Certificate of Completion by: Wesley Sparks RS, date 9/27/95

Operation Permit by: ____ date ____

HEALTH DEPT. COPY: WHITE INSPECTION COPY (FINAL): GREEN OWNER COPY (FINAL): YELLOW INSPECTION COPY (INITIAL): PINK OWNER COPY (INITIAL): GOLD