IREDELL COUNTY HEALTH DEPARTMENT

STATESVILLE 704-878-5305 MOORESVILLE 704-664-5281

IMPROVEMENT PERMIT / CERTIFICATE OF COMPLETION / OPERATION PERMIT / EXISTING SYSTEM INSPECTION

PROPERTY DESCRIPTION NO. 20132 DATE March 30, '95 TAX MAP NO. part of 2SA51 Watershed: ☑ Yes ☐ No

OWNER OR CONTRACTOR Krom Financial Services PHONE: Business 4638-97-6788 Home

ADDRESS 19 Yacht Cove Rd. Mooresville

LOCATION South Rd TR Cornelius Rd TR Mills Pond Rd at end on Right

SUBDIVISION Mills ~~Pond West~~ BLOCK / SECTION LOT 17 LOT AREA 1.63 Ac SITE CLASS. PS per 1952 DESIGN FLOW 360gpd L.T.A.R. .13

Septic Tank: 1000 Pond Gallons; STB 825 RST Date 10-5-95

Pump Tank: Gallons; PT Date

Pump Make: Model Serial No.

Nitrification Field: No Fields 1 Square Feet 1200 Linear Feet 400

No Lines 4 Trench Width 36" Max Trench Bottom Depth 36" Gravel Depth 12"

☑ New System ☐ Repair System Type: I, II, III, IV, V, VI

System Description: gravity conventional

Repair System Description: Inar/pumped area/rock.

Maintenance Agreement Required: ☐ Yes ☑ No

☑ House/Mod. Home No. Bedrooms 3

☐ Mobile Home No. Bathrooms 2

☐ Business No. Employees

☐ Other

☑ Slab ☐ Crawl Space ☐ Basement w/plumbing ☐ Basement wo/plumbing


Water Supply: ☑ Individual ☐ Community ☐ Public

Comments: Much of site obscured by heavy vegetative growth


Comments: [redacted] TO ASW 9/12/95 Home plan reversed - plumbers exited at right rear. Beginning of laterals slightly deeper than ends.

1" = 50'

INITIAL SITE SKETCH

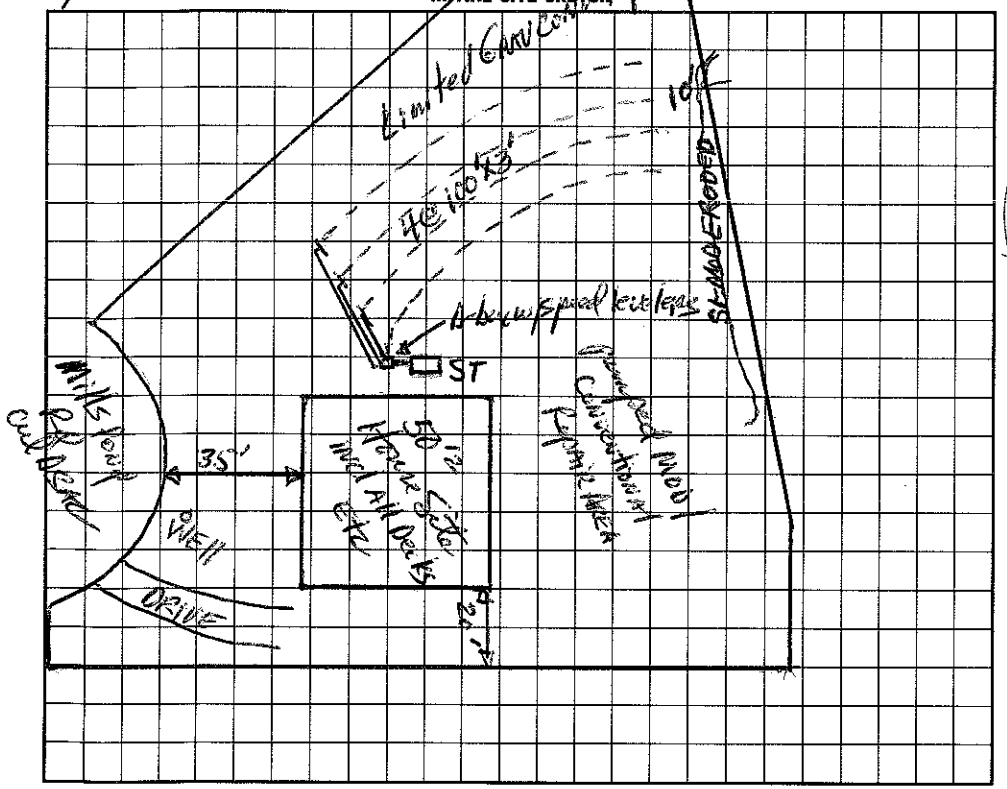

AS BUILT SKETCH

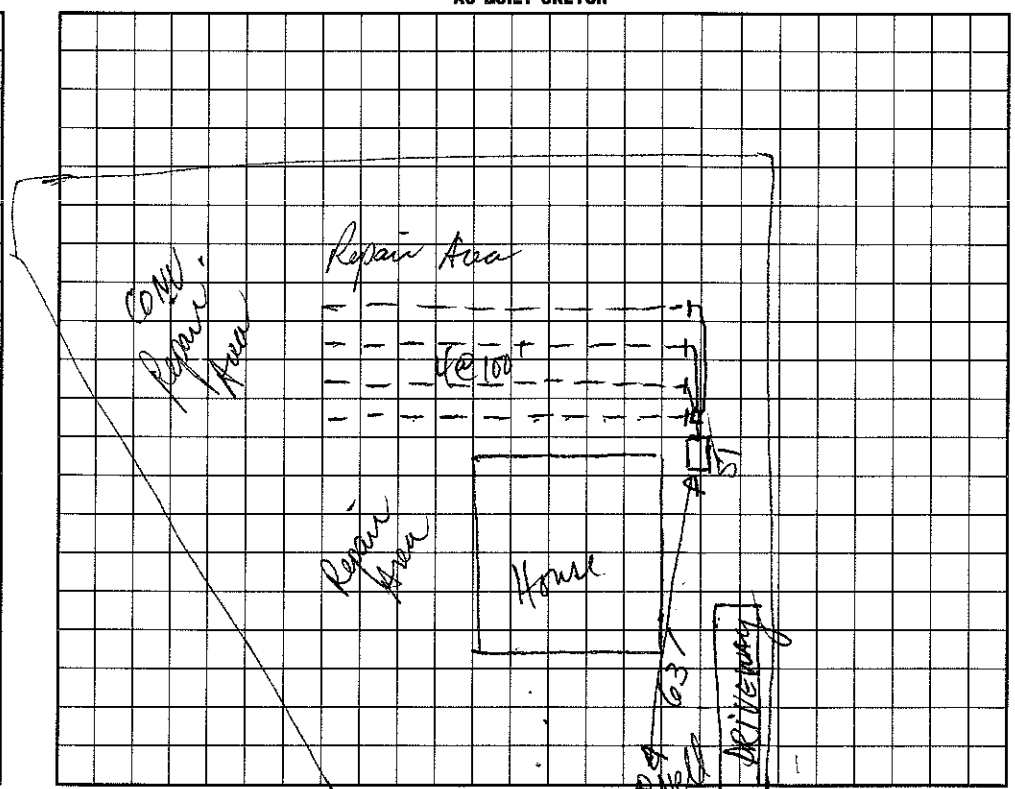

I understand that this permit can be suspended or revoked if any false information is supplied toward securing the permit/any unauthorized changes are made to the site/any unauthorized changes are made in the installation of the system. Improvement Permit is valid for 60 months from date of issuance.

Signed: [redacted] Wesley Hooks R.S. 9/12/95

Improvement Permit by: Harold R. Hinson, RS date 3/30/95

Existing System Inspection by: date

Installed by: Rowan Septic Tank STREET

Certificate of Completion by: date

Operation Permit by: Harold R. Hinson, RS date 1-23-96

HEALTH DEPT. COPY: WHITE INSPECTION COPY (FINAL): GREEN OWNER COPY (FINAL): YELLOW INSPECTION COPY (INITIAL): PINK OWNER COPY (INITIAL): GOLD