IREDELL COUNTY HEALTH DEPARTMENT

STATESVILLE 704-878-5305 — MOORESVILLE 704-664-5281 — Mills Pond

IMPROVEMENT PERMIT / CERTIFICATE OF COMPLETION / OPERATION PERMIT / EXISTING SYSTEM INSPECTION

PROPERTY DESCRIPTION NO. 20133 DATE March 30, '95 TAX MAP NO. part of 2SA51 4638 978698 Watershed: ☑ Yes ☐ No

OWNER OR CONTRACTOR Krom Financial Services PHONE: Business _____ Home _____

ADDRESS 19 Yacht Cove Rd Mooresville

LOCATION Perth Rd TR Cornelius Rd. TL Mills Pond Rd at end on Right Valley

SUBDIVISION Mills Forest West BLOCK / SECTION _____ LOT 18 LOT AREA .82Ac SITE CLASS. B per 1SE DESIGN FLOW 360gpd L.T.A.R. .3

Septic Tank: 1000 Gallons; STB 825 Date 9/14/95

Pump Tank: _____ Gallons; PT PT 47 Date 9/7/95

Pump Make: _____ Model _____ Serial No. _____

Nitrification Field: No. Fields 1 Square Feet 900 Linear Feet 300

No Lines 3 & 4 Trench Width 36" Max Trench Bottom Depth 36" Gravel Depth NA

☑ New System ☐ Repair System Type: I, II, III, IV, V, VI

System Description: Pumped Infiltrator

Repair System Description: _____

Maintenance Agreement Required: ☐ Yes ☐ No

☑ House/Mod. Home No. Bedrooms 3

☐ Mobile Home No. Bathrooms 2

☐ Business No. Employees _____

☐ Other _____

☐ Slab ☑ Crawl Space ☐ Basement w/plumbing ☐ Basement wo/plumbing


Water Supply: ☑ Individual ☐ Community ☐ Public

Comments: Contractor note use of Infiltrator Laterals

Comments: [redacted]

INITIAL SITE SKETCH

1" = 50'

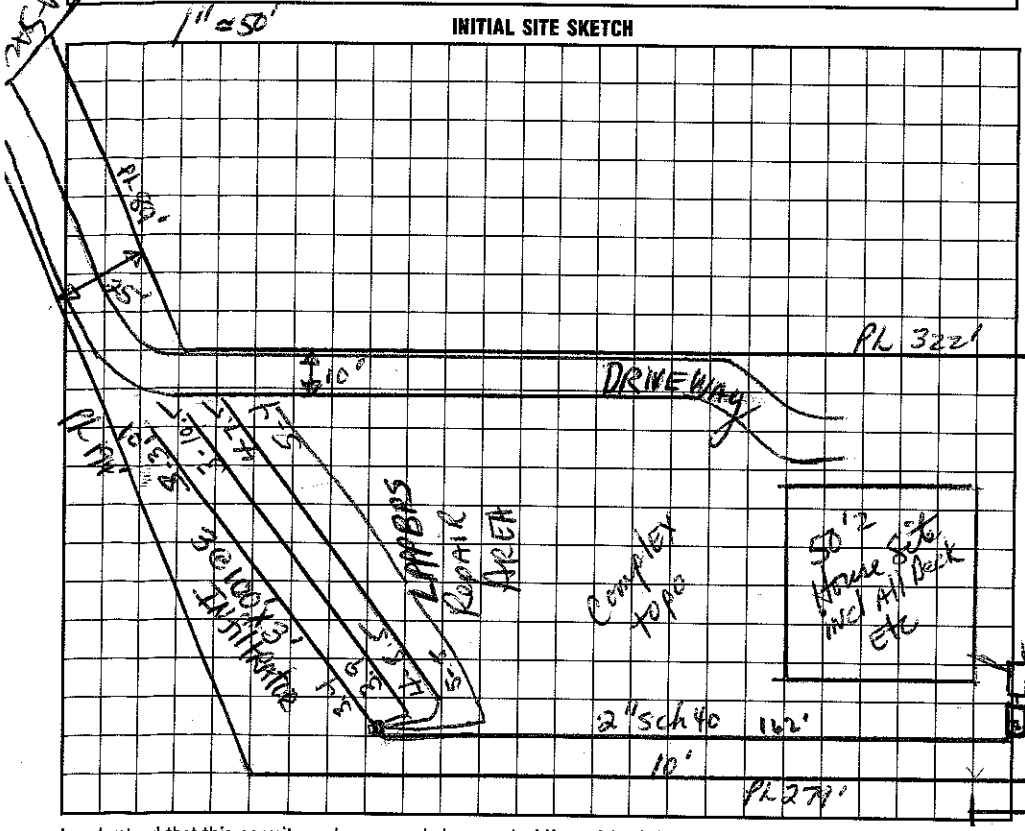

AS BUILT SKETCH

I understand that this permit can be suspended or revoked if any false information is supplied toward securing the permit/any unauthorized changes are made to the site/any unauthorized changes are made in the installation of the system. Improvement Permit is valid for 60 months from date of issuance.

Signed: _____ 9/19/95

Improvement Permit by: Janet R. Hinson, RS Wesley Sparks date 3/30/95

Existing System Inspection by: _____ date _____

Installed by: Rowan Septic Tank

Certificate of Completion by: Wesley Sparks R.S. date 1/3/96

Operation Permit by: Wesley Sparks R.S. date 1/3/96

HEALTH DEPT. COPY: WHITE — INSPECTION COPY (FINAL): GREEN — OWNER COPY (FINAL): YELLOW — INSPECTION COPY (INITIAL): PINK — OWNER COPY (INITIAL): GOLD