IREDELL COUNTY HEALTH DEPARTMENT

STATESVILLE 704-878-5305 MOORESVILLE 704-664-5281

IMPROVEMENT PERMIT / ~~CERTIFICATE OF COMPLETION~~ / OPERATION PERMIT / EXISTING SYSTEM INSPECTION

1 AUTHORIZATION TO CONSTRUCT 2nd

PROPERTY DESCRIPTION NO. 20115 DATE 11/7/97 TAX MAP NO. pt of 25451 Watershed: ~~Yes~~ No

OWNER OR CONTRACTOR Krom Financial / ALLEN WALKER PHONE: Business Home 557-5059

ADDRESS 385 Phaniels Church Rd - Roxboro NC 27573 (638-97-9479)

LOCATION ~~from~~ PERTH - TR CORNELIUS - ON LEFT BEFORE LAKE.

SUBDIVISION MILLS POND BLOCK / SECTION LOT 1 LOT AREA .69AC SITE CLASS. PS DESIGN FLOW 360 L.T.A.R. .3

Septic Tank: 1000 Gallons; STB 825 Date

Pump Tank: Gallons; PT Date

Pump Make: Model Serial No.

Nitrification Field: No Fields 1 Square Feet 900 Linear Feet 300

No Lines 3@100 Trench Width 36" Max Trench Bottom Depth 36" Gravel Depth N/A

☑ New System ☐ Repair System Type: I, II, III, IV, V, VI

System Description: GRAVITY CHAMBERED OR HS

Repair System Description: PUMP SAME

Maintenance Agreement Required: ☐ Yes ☑ No

☑ House/Mod. Home No. Bedrooms 3

☐ Mobile Home No. Bathrooms 2

☐ Business No. Employees

☐ Other

☐ Slab ☑ Crawl Space ☐ Basement w/plumbing ☐ Basement wo/plumbing


Water Supply: ☑ Individual ☐ Community ☐ Public

Comments:

Comments:

Installed as Drawn.

INITIAL SITE SKETCH

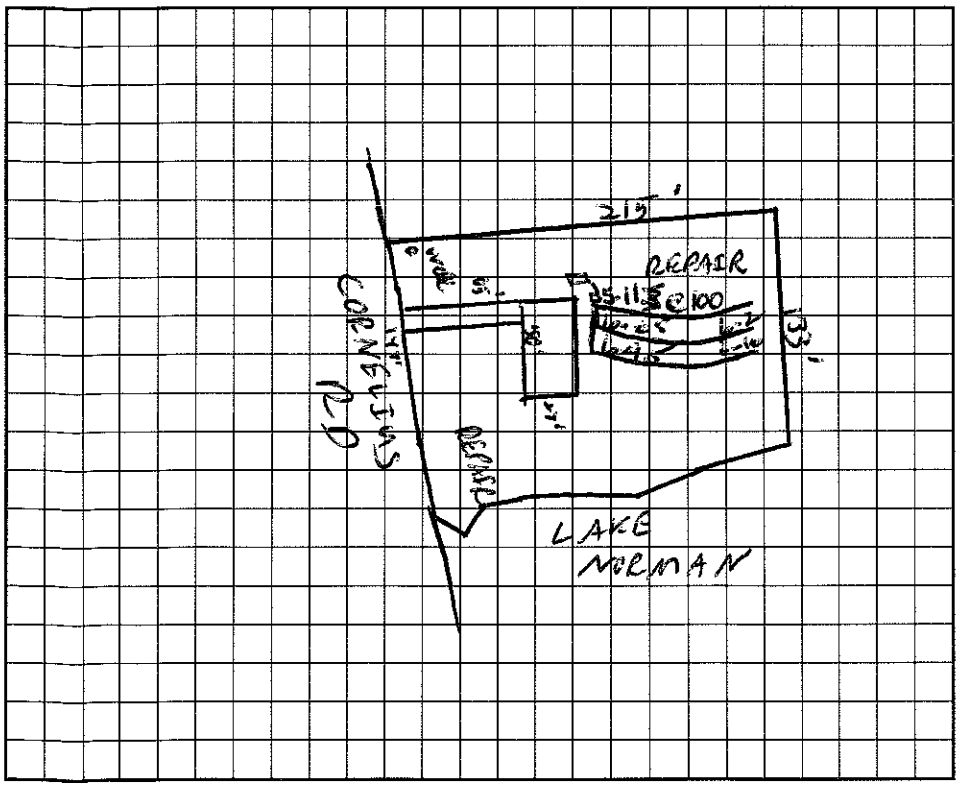

AS BUILT SKETCH

I understand that this permit can be suspended or revoked if any false information is supplied toward securing the permit/any unauthorized changes are made to the site/any unauthorized changes are made in the installation of the system. Improvement Permit is valid for 60 months from date of issuance.

Signed: Allen Walker

Installed by: Rowan

Improvement Permit by: C. Rob Tesar date 11/7/97

Certificate of Completion by: Wesley Sparks RS. date 4/24/98

~~Existing System Inspection by:~~ AUTHORIZATION TO CONSTRUCT C. Rob Tesar date 11/7/97

Operation Permit by: Wesley Sparks RS. date 4/24/98

HEALTH DEPT. COPY: WHITE INSPECTION COPY (FINAL): GREEN OWNER COPY (FINAL): YELLOW INSPECTION COPY (INITIAL): PINK OWNER COPY (INITIAL): GOLD