IREDELL COUNTY HEALTH DEPARTMENT

STATESVILLE 704-878-5305 MOORESVILLE 704-664-5281

IMPROVEMENT PERMIT / CERTIFICATE OF COMPLETION / OPERATION PERMIT / EXISTING SYSTEM INSPECTION

PROPERTY DESCRIPTION NO. 20125 DATE March 29, 95 TAX MAP NO. part of 2SA51 Watershed: ☑ Yes ☐ No WSIV

OWNER OR CONTRACTOR Krom Financial Services PHONE: Business 664-3671 Home

ADDRESS 19 Yacht Cove Rd, Mooresville 4638-98-0322

LOCATION Perth Road / TR Cornelius Rd ~ 1/4 mile on left

SUBDIVISION Mills Forest West BLOCK / SECTION LOT 10 LOT AREA .55 Ac SITE CLASS. PS DESIGN FLOW 360 gpd L.T.A.R. 0.3

Septic Tank: 1000 Gallons; STB 825 Date 4/21/95

Pump Tank: Gallons; PT Date

Pump Make: Model Serial No.

Nitrification Field: No Fields 1 Square Feet 1200 Linear Feet 400

No Lines 4 Trench Width 36" Max Trench Bottom Depth 36" Gravel Depth 12"

☑ New System ☐ Repair System Type: I, (II), III, IV, V, VI

System Description: gravity conventional

Repair System Description: grav / pumped conv.

Maintenance Agreement Required: ☐ Yes ☑ No

☑ House/Mod. Home No. Bedrooms 3
☐ Mobile Home No. Bathrooms 2
☐ Business No. Employees
☐ Other

☐ Slab ☑ Crawl Space ☐ Basement w/plumbing ☐ Basement wo/plumbing


Water Supply: ☑ Individual ☐ Community ☐ Public

Comments:

Comments: [redacted]

1" = 50'

INITIAL SITE SKETCH

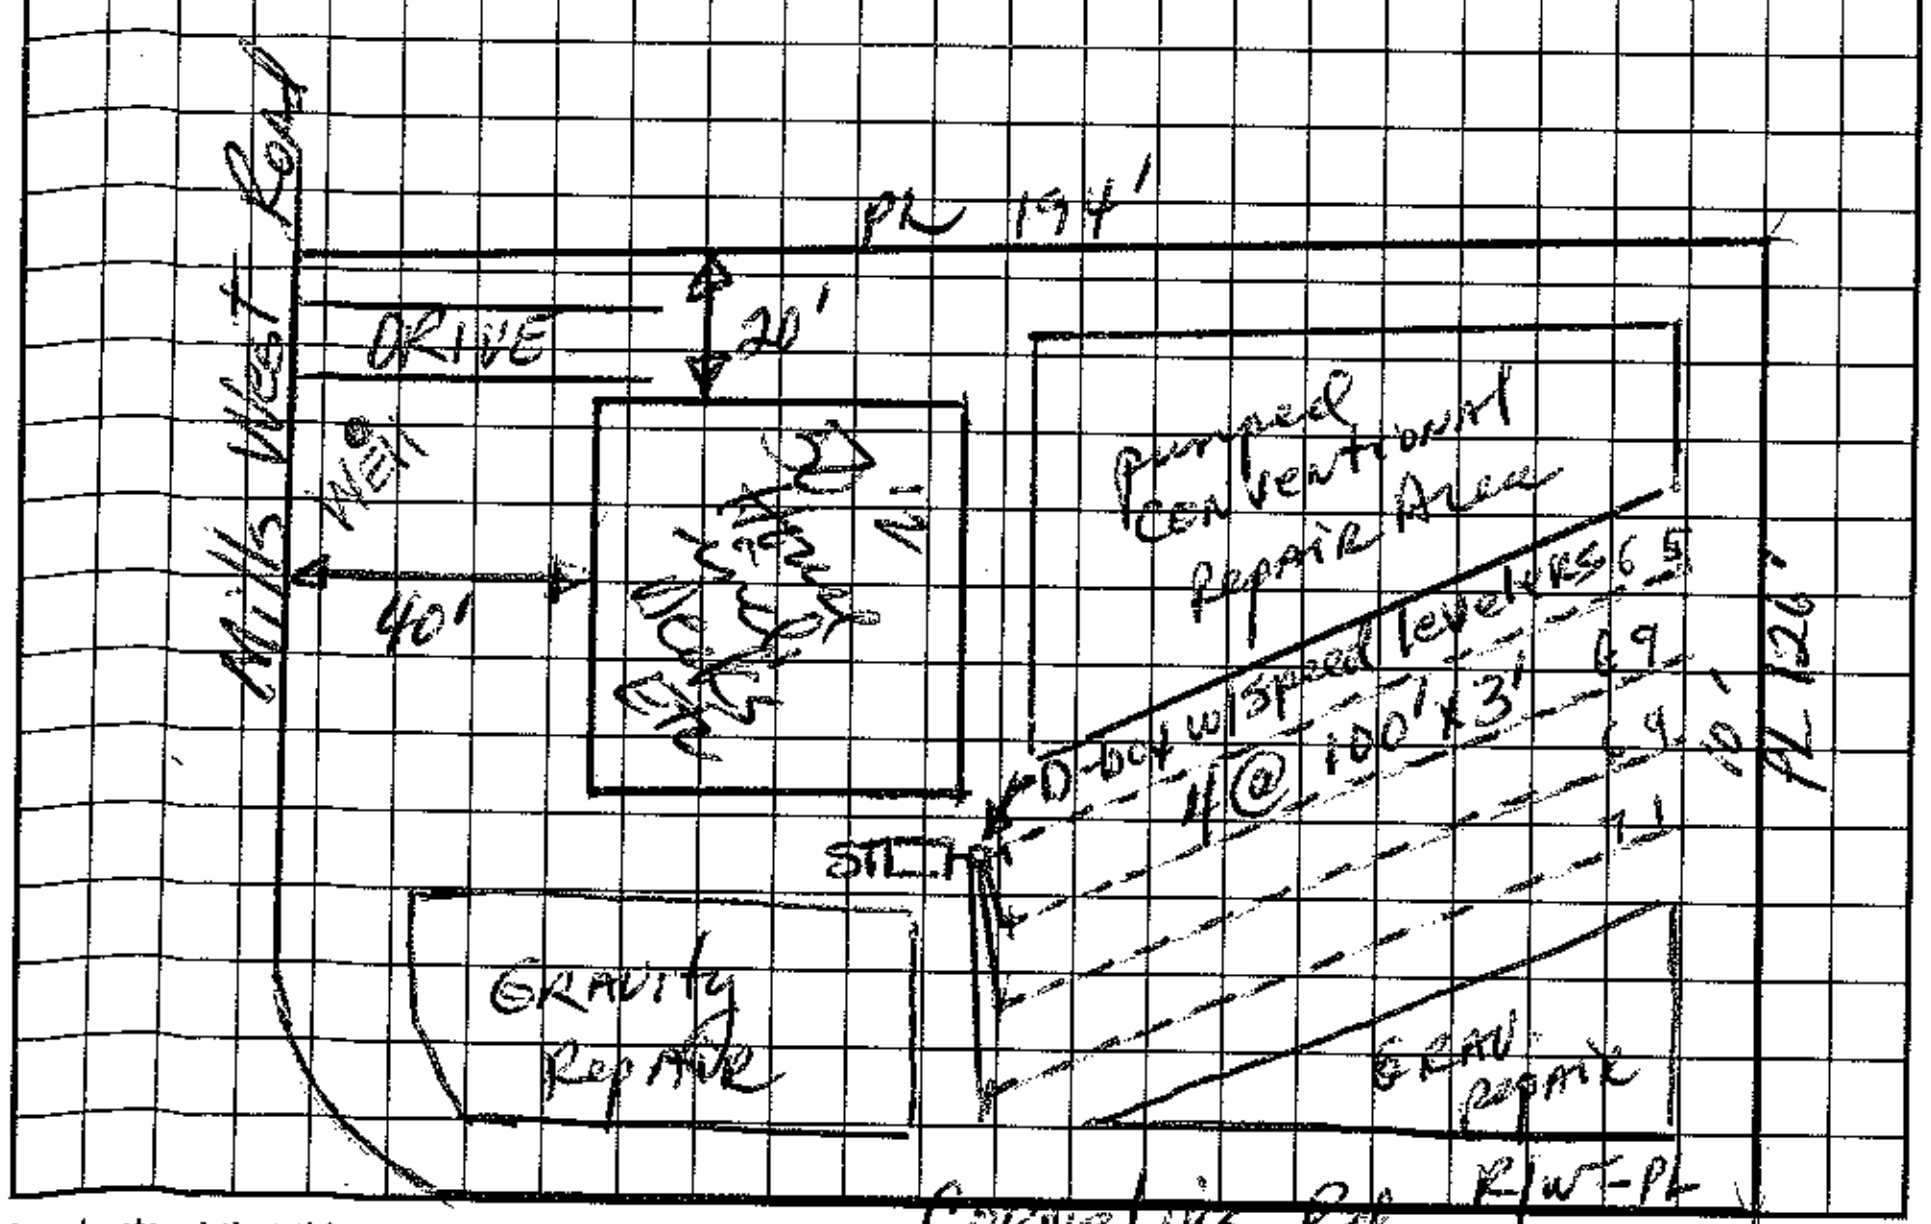

AS BUILT SKETCH

I understand that this permit can be suspended or revoked if any false information is supplied toward securing the permit/any unauthorized changes are made to the site/any unauthorized changes are made in the installation of the system. Improvement Permit is valid for 60 months from date of issuance.

Signed

Improvement Permit by Dave R. Henson, RS / Wesley Sparks 9/9/95 date 3/29/95

Existing System Inspection by: date

Installed by: Rowan Septic Tank

Certificate of Completion by: Wesley Sparks RS. date 12/22/95

Operation Permit by: Wesley Sparks RS. date 12/22/95

HEALTH DEPT. COPY: WHITE INSPECTION COPY (FINAL): GREEN OWNER COPY (FINAL): YELLOW INSPECTION COPY (INITIAL): PINK OWNER COPY (INITIAL): GOLD