IREDELL COUNTY HEALTH DEPARTMENT

STATESVILLE 704-878-5305 MOORESVILLE 704-664-5281

IMPROVEMENT PERMIT / CERTIFICATE OF COMPLETION / OPERATION PERMIT / EXISTING SYSTEM INSPECTION

PROPERTY DESCRIPTION NO. 20142 DATE March 27, '95 TAX MAP NO. 4615/25A51 Watershed: ☑ Yes ☐ No WSIV

OWNER OR CONTRACTOR From Financial Services PHONE: Business 664/3671 Home 4638-98-0536

ADDRESS 19 Yacht Cove Rd, Mooresville

LOCATION North Rd TR Cornelius Rd TL Mills Pond Rd 1st lot on left (corner lot)

SUBDIVISION Mills Forest West BLOCK / SECTION ____ LOT 27 LOT AREA .72ac SITE CLASS. ~~BSpa~~ 1956 DESIGN FLOW 360gpd L.T.A.R. .3

Septic Tank: 1000 Gallons; STB 825 Date 5/14/95

Pump Tank: ____ Gallons; PT ____ Date ____

Pump Make: ____ Model ____ Serial No. ____

Nitrification Field: No Fields 1 Square Feet 1200 Linear Feet 400

No Lines 5 Trench Width 36" Max Trench Bottom Depth 30" Gravel Depth 12"

☑ New System ☐ Repair System Type: I, II, III, IV, V, VI

System Description: gravity conventional

Repair System Description: ~~gravity~~ PPBPS

Maintenance Agreement Required: ☐ Yes ☑ No

☑ House/Mod. Home No. Bedrooms 3

☐ Mobile Home No. Bathrooms 2

☐ Business No. Employees ____

☐ Other ____


☐ Slab ☑ Crawl Space ☐ Basement w/plumbing ☐ Basement wo/plumbing

Water Supply: ☑ Individual ☐ Community ☐ Public

Comments:

Comments: ~~DEVELOPER~~ Ready to release 6/15/95 AWS ~~PERMIT~~

INITIAL SITE SKETCH

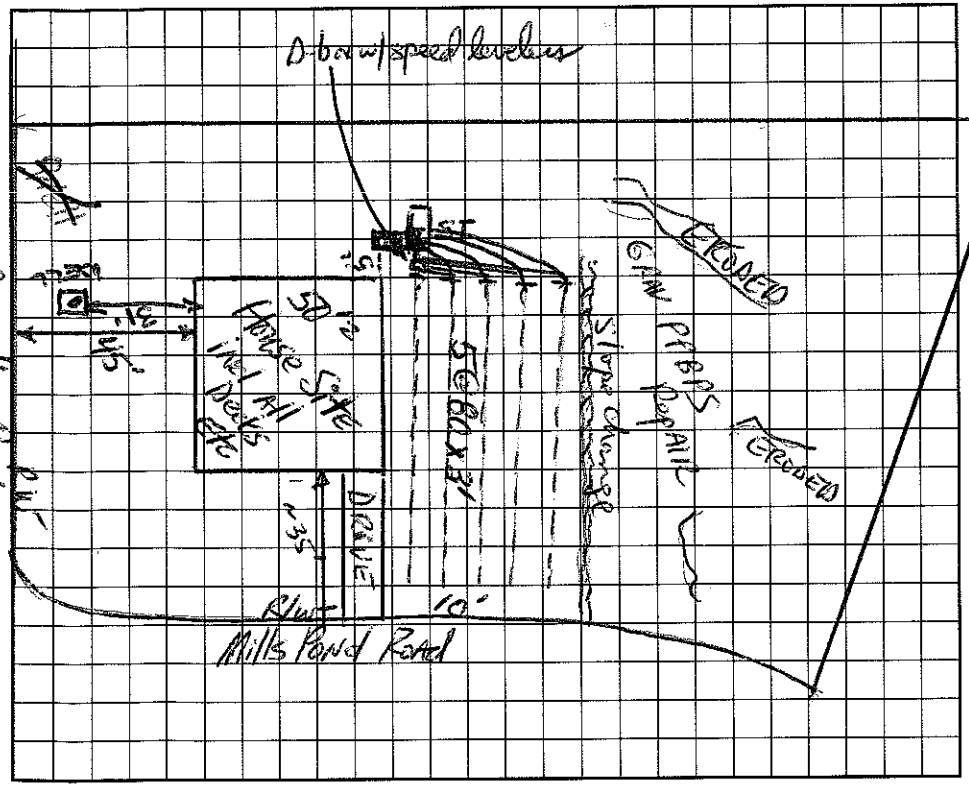

AS BUILT SKETCH

I understand that this permit can be suspended or revoked if any false information is supplied toward securing the permit/any unauthorized changes are made to the site/any unauthorized changes are made in the installation of the system. Improvement Permit is valid for 60 months from date of issuance.

Signed: ____

Improvement Permit by: [signature] RS AWS date 3/27/95

Existing System Inspection by: ____ date ____

Installed by: Rowan Septic Tank 6/15/95

Certificate of Completion by: Wesley Sparks RS date 8/16/95

Operation Permit by: ____ date ____

HEALTH DEPT. COPY: WHITE INSPECTION COPY (FINAL): GREEN OWNER COPY (FINAL): YELLOW INSPECTION COPY (INITIAL): PINK OWNER COPY (INITIAL): GOLD