IREDELL COUNTY HEALTH DEPARTMENT

Authorization to Construct

STATESVILLE 704-878-5305 MOORESVILLE 704-664-5281

IMPROVEMENT PERMIT / ~~CERTIFICATE OF COMPLETION~~ / OPERATION PERMIT / EXISTING SYSTEM INSPECTION

PROPERTY DESCRIPTION NO. 20143 DATE March 27, '95 TAX MAP NO. part of 2545A51 Watershed: ☑ Yes ☐ No Water

OWNER OR CONTRACTOR Kyom Financial Services PHONE: Business 4638-98-0628 Home

ADDRESS 19 Yadkin Ave Rd Mooresville

LOCATION North Rd TO Cornelius Rd. n 1100' on left

SUBDIVISION Mills Trail West BLOCK / SECTION LOT 28 LOT AREA 1.82 Ac SITE CLASS. P3 DESIGN FLOW 360 gpd L.T.A.R. #3

Septic Tank: 1000 Poly Gallons; STB 825 Date 9/1/95

Pump Tank: Gallons; PT Date

Pump Make: Model Serial No.

Nitrification Field: No Fields 1 Square Feet 1200 Linear Feet 400

No Lines 4 Trench Width 36" Max Trench Bottom Depth 24" Gravel Depth 12"

☑ New System ☐ Repair System Type: I, II, III, IV, V, VI

System Description: gravity conventional

Repair System Description: same

Maintenance Agreement Required: ☐ Yes ☑ No

☐ House/Mod. Home No. Bedrooms 3

☐ Mobile Home No. Bathrooms 2

☐ Business No. Employees

☐ Other

☐ Slab ☑ Crawl Space ☐ Basement w/plumbing ☐ Basement wo/plumbing


Water Supply: ☑ Individual ☐ Community ☐ Public

Comments:


Comments: Ready to Issue

1" = 50'

INITIAL SITE SKETCH

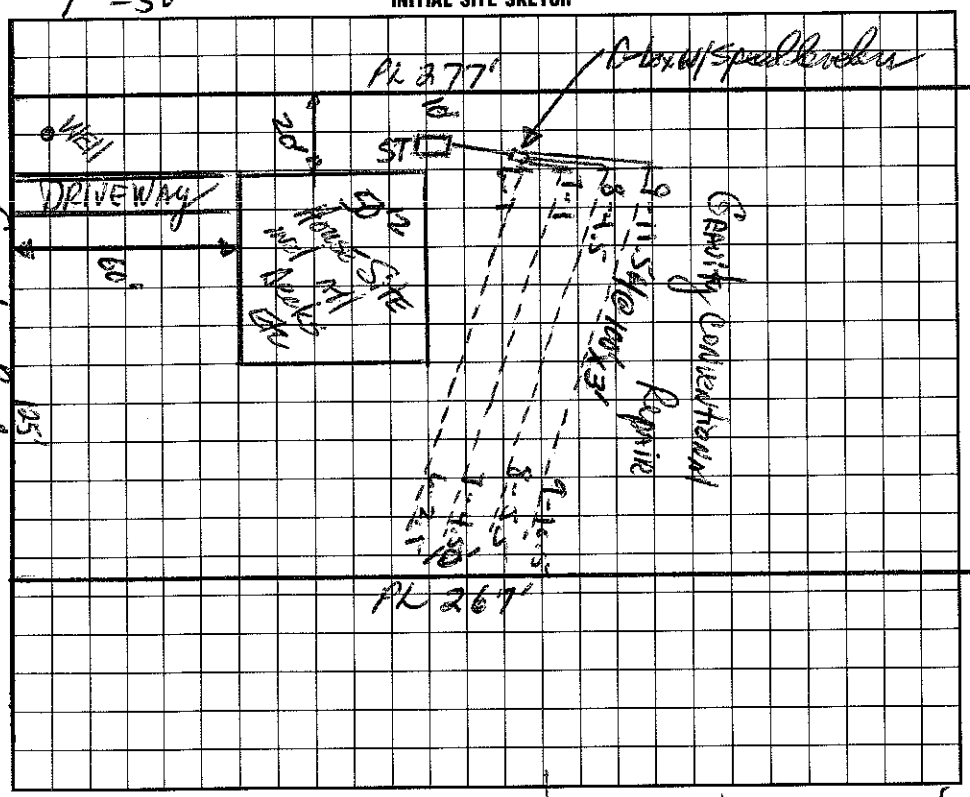

AS BUILT SKETCH

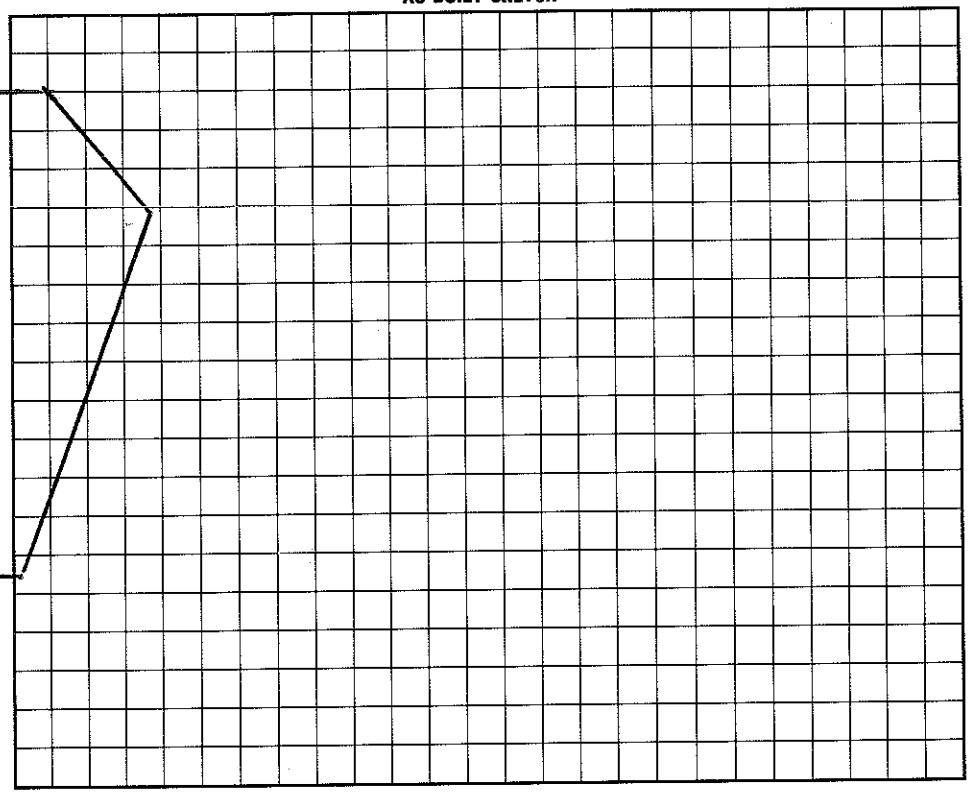

I understand that this permit can be suspended or revoked if any false information is supplied toward securing the permit/any unauthorized changes are made to the site/any unauthorized changes are made in the installation of the system. Improvement Permit is valid for 60 months from date of issuance.

Signed: Wesley Sparks RS 9/7/95

Improvement Permit by: [signature] RS date 3/27/95

~~Existing System Inspection by:~~ AUTHORIZATION TO CONSTRUCT date

Installed by: Rowan Septic Tank

Certificate of Completion by: date

Operation Permit by: Wesley Sparks RS. date 10/5/95

HEALTH DEPT. COPY: WHITE INSPECTION COPY (FINAL): GREEN OWNER COPY (FINAL): YELLOW INSPECTION COPY (INITIAL): PINK OWNER COPY (INITIAL): GOLD