IREDELL COUNTY HEALTH DEPARTMENT

STATESVILLE 704-878-5305 MOORESVILLE 704-664-5281

IMPROVEMENT PERMIT / CERTIFICATE OF COMPLETION / OPERATION PERMIT / EXISTING SYSTEM INSPECTION

PROPERTY DESCRIPTION NO. 20126 DATE March 29 '95 TAX MAP NO. part of 2SA51 Watershed: ☑ Yes ☐ No

OWNER OR CONTRACTOR Kram Financial Services PHONE: Business 664-3671 ~~Home~~ 4638-98-1354 WSIV

ADDRESS 19 Yacht Cove Rd. / Mooresville

LOCATION Forth Rd. & JR Cornelius Rd. TL Mills West Rd. 2nd lot on Right

SUBDIVISION Mills ~~West~~ West BLOCK / SECTION ____ LOT 11 LOT AREA .54 Ac SITE CLASS. PS per 1956 DESIGN FLOW 360 gpd L.T.A.R. .03

Septic Tank: 1000 Gallons; STB 825 Date 2/11/96

Pump Tank: ____ Gallons; PT ____ Date ____

Pump Make: ____ Model ____ Serial No. ____

Nitrification Field: No Fields 1 Square Feet 1200 Linear Feet 400

No Lines 4 Trench Width 36" Max Trench Bottom Depth 36" Gravel Depth 12"

☑ New System ☐ Repair System Type: I, II, III, IV, V, VI

System Description: gravity conventional

Repair System Description: gravity pumped MOD (INF.)

Maintenance Agreement Required: ☐ Yes ☑ No

☑ House/Mod. Home No. Bedrooms 3

☐ Mobile Home No. Bathrooms 2

☐ Business No. Employees ____

☐ Other ____

☐ Slab ☑ Crawl Space ☐ Basement w/plumbing ☐ Basement wo/plumbing


Water Supply: ☑ Individual ☐ Community ☐ Public

Comments:


Comments: DEVELOPER PERMIT

1" = 50'

INITIAL SITE SKETCH

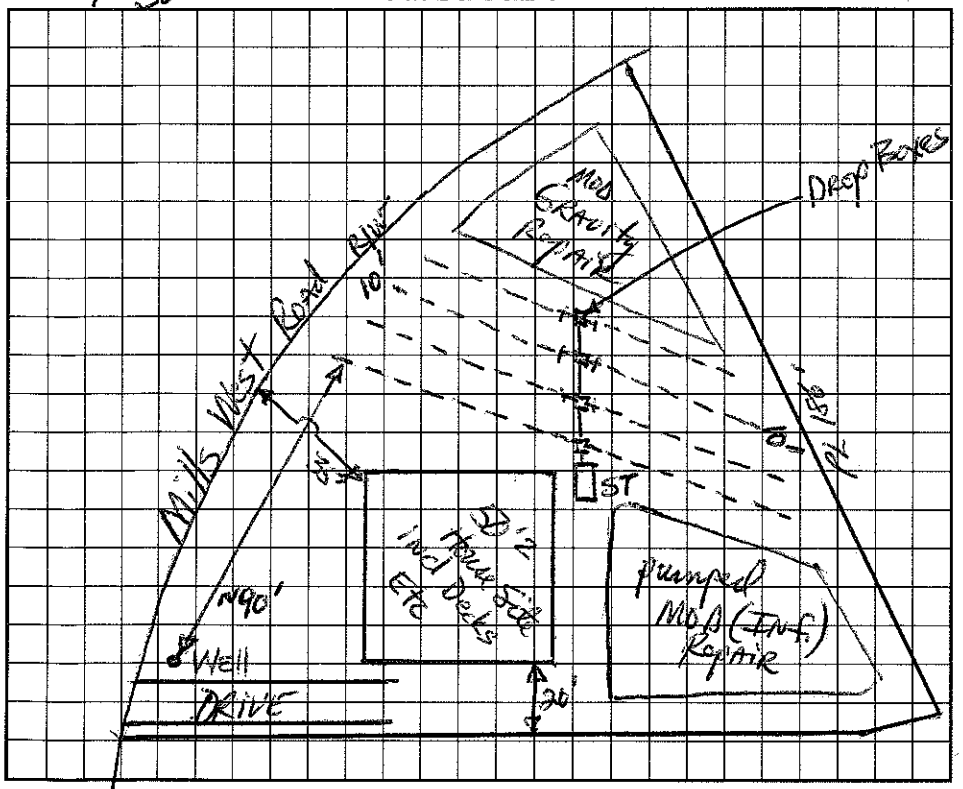

AS BUILT SKETCH

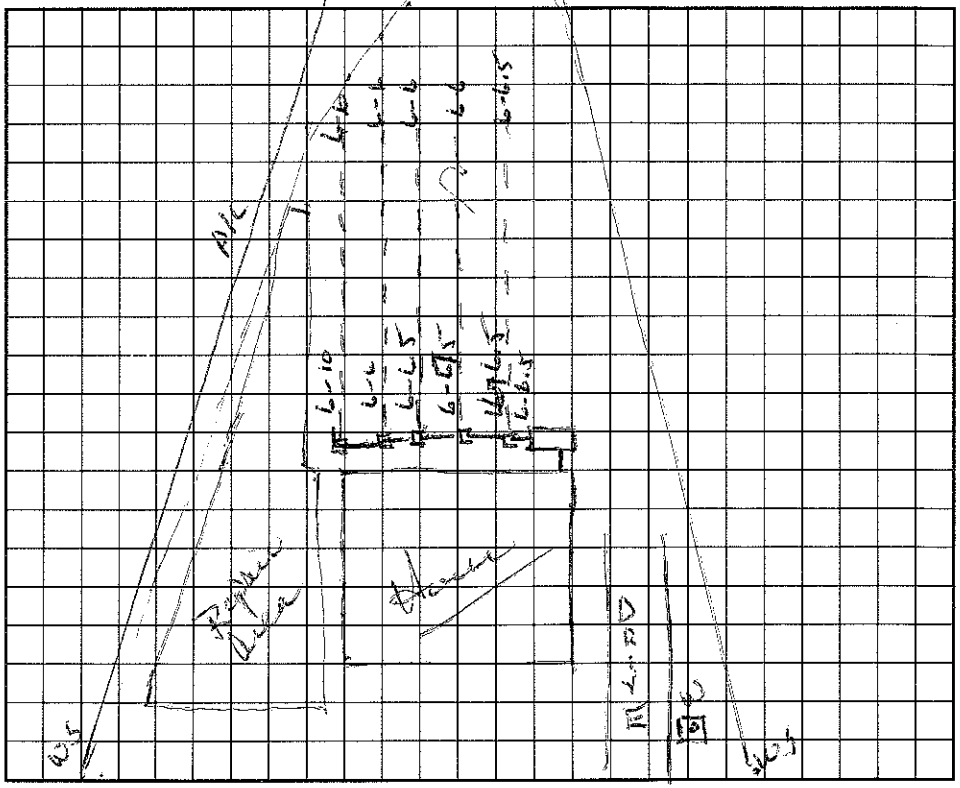

I understand that this permit can be suspended or revoked if any false information is supplied toward securing the permit/any unauthorized changes are made to the site/any unauthorized changes are made in the installation of the system. Improvement Permit is valid for 60 months from date of issuance.

Signed: [signature]

Improvement Permit by: Jack R Hinson RS date 3/29/95

Existing System Inspection by: ____ date ____

Installed by: Rowan Septic Tank

Certificate of Completion by: ____ date ____

Operation Permit by: Wesley Sparks R.S. date 5/6/96

HEALTH DEPT. COPY: WHITE INSPECTION COPY (FINAL): GREEN OWNER COPY (FINAL): YELLOW INSPECTION COPY (INITIAL): PINK OWNER COPY (INITIAL): GOLD