IREDELL COUNTY HEALTH DEPARTMENT

STATESVILLE 704-878-5305 MOORESVILLE 704-664-5281

IMPROVEMENT PERMIT / CERTIFICATE OF COMPLETION / OPERATION PERMIT / EXISTING SYSTEM INSPECTION

PROPERTY DESCRIPTION NO. 2014 DATE March 31, 95 TAX MAP NO. part of 2545 Watershed: ☑ Yes ☐ No WS IV

OWNER OR CONTRACTOR Kiser Financial Services PHONE: Business Home 4638-98-2528

ADDRESS 19 Hart Cove Rd, Mooresville

LOCATION Smith Rd N. to R Cornelius Rd to L Mills Pond Rd. 2nd on left

SUBDIVISION Mills Forest West BLOCK / SECTION LOT 26 LOT AREA 1.65 Ac SITE CLASS B Sept 95 DESIGN FLOW 360 gpd L.T.A.R. .3

Septic Tank: 1000 Poly Gallons; STB 825 Date 2/19/95

Pump Tank: Gallons; PT Date

Pump Make: Model Serial No.

Nitrification Field: No Fields 1 Square Feet 900 Linear Feet 300

No Lines 3 Trench Width 36" Max Trench Bottom Depth 36" Gravel Depth NA

☑ New System ☐ Repair System Type: I, II, III, IV, V, VI

System Description: gravity-infiltrator

Repair System Description: New proposed IDF

Maintenance Agreement Required: ☐ Yes ☑ No

☑ House/Mod. Home No. Bedrooms 3

☐ Mobile Home No. Bathrooms 2

☐ Business No. Employees

☐ Other

☐ Slab ☑ Crawl Space ☐ Basement w/plumbing ☐ Basement wo/plumbing

Water Supply: ☑ Individual ☐ Community ☐ Public


Comments:

Comments: Ready for Issuance 6/15/95 AWS

DEVELOPER PERMIT

1"=50'

INITIAL SITE SKETCH

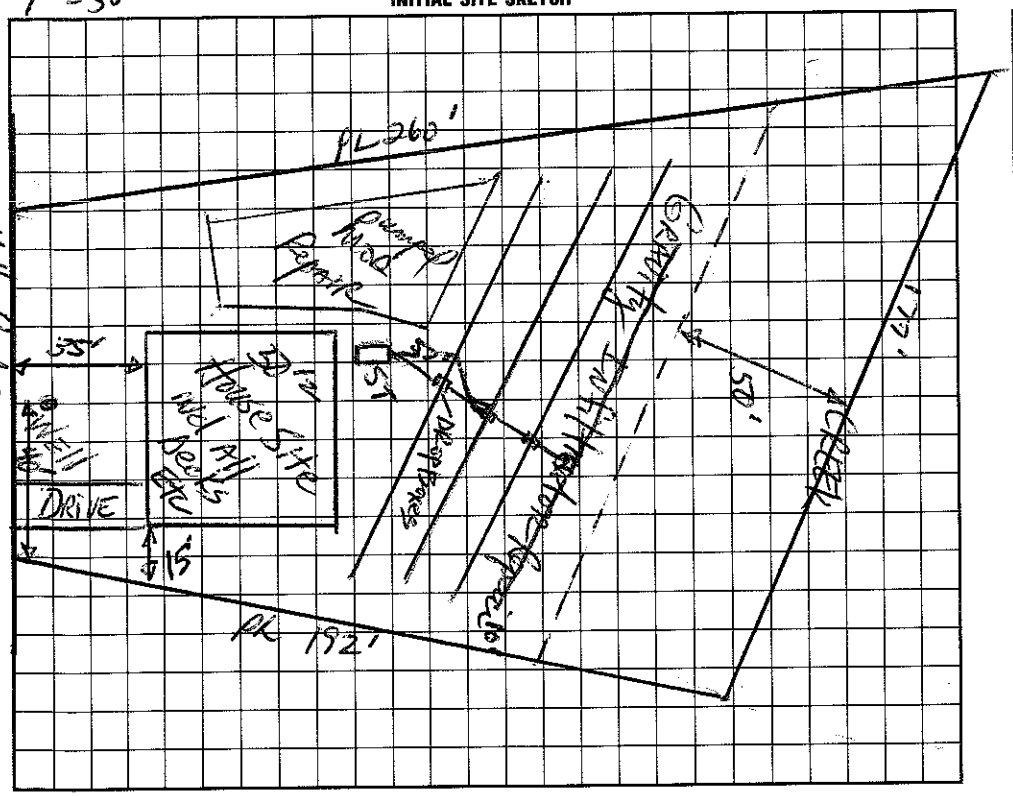

AS BUILT SKETCH

I understand that this permit can be suspended or revoked if any false information is supplied toward securing the permit/any unauthorized changes are made to the site/any unauthorized changes are made in the installation of the system. Improvement Permit is valid for 60 months from date of issuance.

Signed: 6/15/95

Improvement Permit by: Derek R Hanson, RS AWS date 3/31/95

Existing System Inspection by: date

Installed by: Kowan Septic Tank

Certificate of Completion by: Wesley Sparks RS. date 8/22/95

Operation Permit by: date

HEALTH DEPT. COPY: WHITE INSPECTION COPY (FINAL): GREEN OWNER COPY (FINAL): YELLOW INSPECTION COPY (INITIAL): PINK OWNER COPY (INITIAL): GOLD