2.30

IREDELL COUNTY HEALTH DEPARTMENT

STATESVILLE 704-878-5305 MOORESVILLE 704-664-5281

IMPROVEMENT PERMIT / CERTIFICATE OF COMPLETION / OPERATION PERMIT / EXISTING SYSTEM INSPECTION

PROPERTY DESCRIPTION NO. 20550 DATE April 23, '95 TAX MAP NO. part of 2SA51 4638 982837 Watershed: ☑ Yes ☐ No

OWNER OR CONTRACTOR Ryan Financial Services PHONE: Business _____ Home _____ WSW

ADDRESS 19 Yacht Cove Rd. Mooresville

LOCATION Keith Rd N. to Cornelius Rd. TL Creek View Lane 7th lot on Right

SUBDIVISION Mills Pond BLOCK / SECTION 2 LOT 38 LOT AREA 1.9 ac SITE CLASS. PS DESIGN FLOW 360gpd L.T.A.R. .3

Septic Tank: 1000 Gallons; STB ~~1000~~ Date 7-14-97

Pump Tank: 1000 Gallons; PT ~~1000~~ 475 Date 8-3-97

Pump Make: Zoeller Model N137-C Serial No. _____

Nitrification Field: No Fields 1 Square Feet 1200 Linear Feet 400

No Lines 4 Trench Width 36" Max Trench Bottom Depth 36" Gravel Depth 12"

☑ New System ☐ Repair System Type: I, II, ☑ III, IV, V, VI

System Description: pumped conventional

Repair System Description: pumped IN filtrator

Maintenance Agreement Required: ☐ Yes ☑ No

☑ House/Mod. Home ☐ Mobile Home ☐ Business ☐ Other

No. Bedrooms 3 No. Bathrooms 2 No. Employees _____

Water Supply: ☑ Individual ☐ Community ☐ Public


☐ Slab ☑ Crawl Space ☐ Basement w/plumbing ☐ Basement wo/plumbing

Comments: Checked lines & tank 9/17/97 CREED MD

Comments: DEVELOPER TO PERMIT 9/23/95 AWS Nemalx Box & Alarm Checked

1"=50'

INITIAL SITE SKETCH

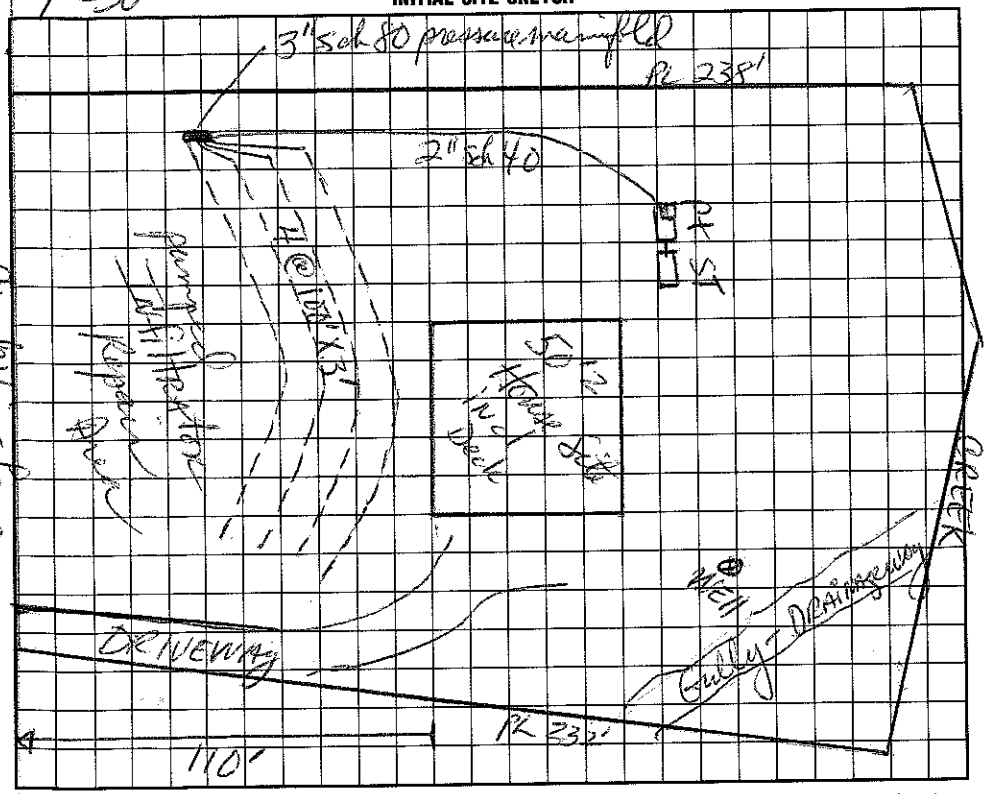

AS BUILT SKETCH

I understand that this permit can be suspended or revoked if any false information is supplied toward securing the permit/any unauthorized changes are made to the site/any unauthorized changes are made in the installation of the system. Improvement Permit is valid for 60 months from date of issuance.

Signed: X Wesley Sparks RS 9/23/95

Improvement Permit by: Robert B Henson RS date 9/23/95

Existing System Inspection by: _____ date _____

Installed by: Rowan Septic

Certificate of Completion by: Maria H H Dolan date 9/24/97

Operation Permit by: Maria H H Dolan date 9/24/97

HEALTH DEPT COPY: WHITE INSPECTION COPY (FINAL): GREEN OWNER COPY (FINAL): YELLOW INSPECTION COPY (INITIAL): PINK OWNER COPY (INITIAL): GOLD