IREDELL COUNTY HEALTH DEPARTMENT

STATESVILLE 704-878-5305 MOORESVILLE 704-664-5281

IMPROVEMENT PERMIT / CERTIFICATE OF COMPLETION / OPERATION PERMIT / EXISTING SYSTEM INSPECTION

PROPERTY DESCRIPTION NO. 20140 DATE March 31, '95 TAX MAP NO. part of 25A51 Watershed: ☑ Yes ☐ No WSIV

OWNER OR CONTRACTOR Krom Financial Services PHONE: Business 664 3671 Home

ADDRESS 19 Yacht Cove Rd, Mooresville 4638-98-3530

LOCATION Perth Rd TR Cornelius Rd TL Mills Pond Rd 3rd on left

SUBDIVISION Mills ~~Point West~~ Pond BLOCK / SECTION ______ LOT 25 LOT AREA .66 Ac SITE CLASS PS per 1956 DESIGN FLOW 360 gpd L.T.A.R. .3

Septic Tank: 1000 Gallons; STB 825 Date 7/17/95 ☑ New System ☐ Repair System Type: I, II, (III), IV, V, VI ☑ House/Mod. Home No. Bedrooms 3 Water Supply: ☑ Individual

Pump Tank: ______ Gallons; PT ______ Date ______ System Description: gravity Infiltrator ☐ Mobile Home No. Bathrooms 2 ☐ Community

Pump Make: ______ Model ______ Serial No. ______ Repair System Description: pumped Infiltrator ☐ Business No. Employees ______ ☐ Public

Nitrification Field: No Fields 1 Square Feet 900 Linear Feet 300 Maintenance Agreement Required: ☐ Yes ☑ No ☐ Other ______


No Lines 4 3 Trench Width 36" Max Trench Bottom Depth 36" Gravel Depth NA ☐ Slab ☑ Crawl Space ☐ Basement w/plumbing ☐ Basement wo/plumbing

Comments:

Comments: ~~DEVELOPER~~ Ready for issue 6/15/95 AWS

1" = 50'

INITIAL SITE SKETCH

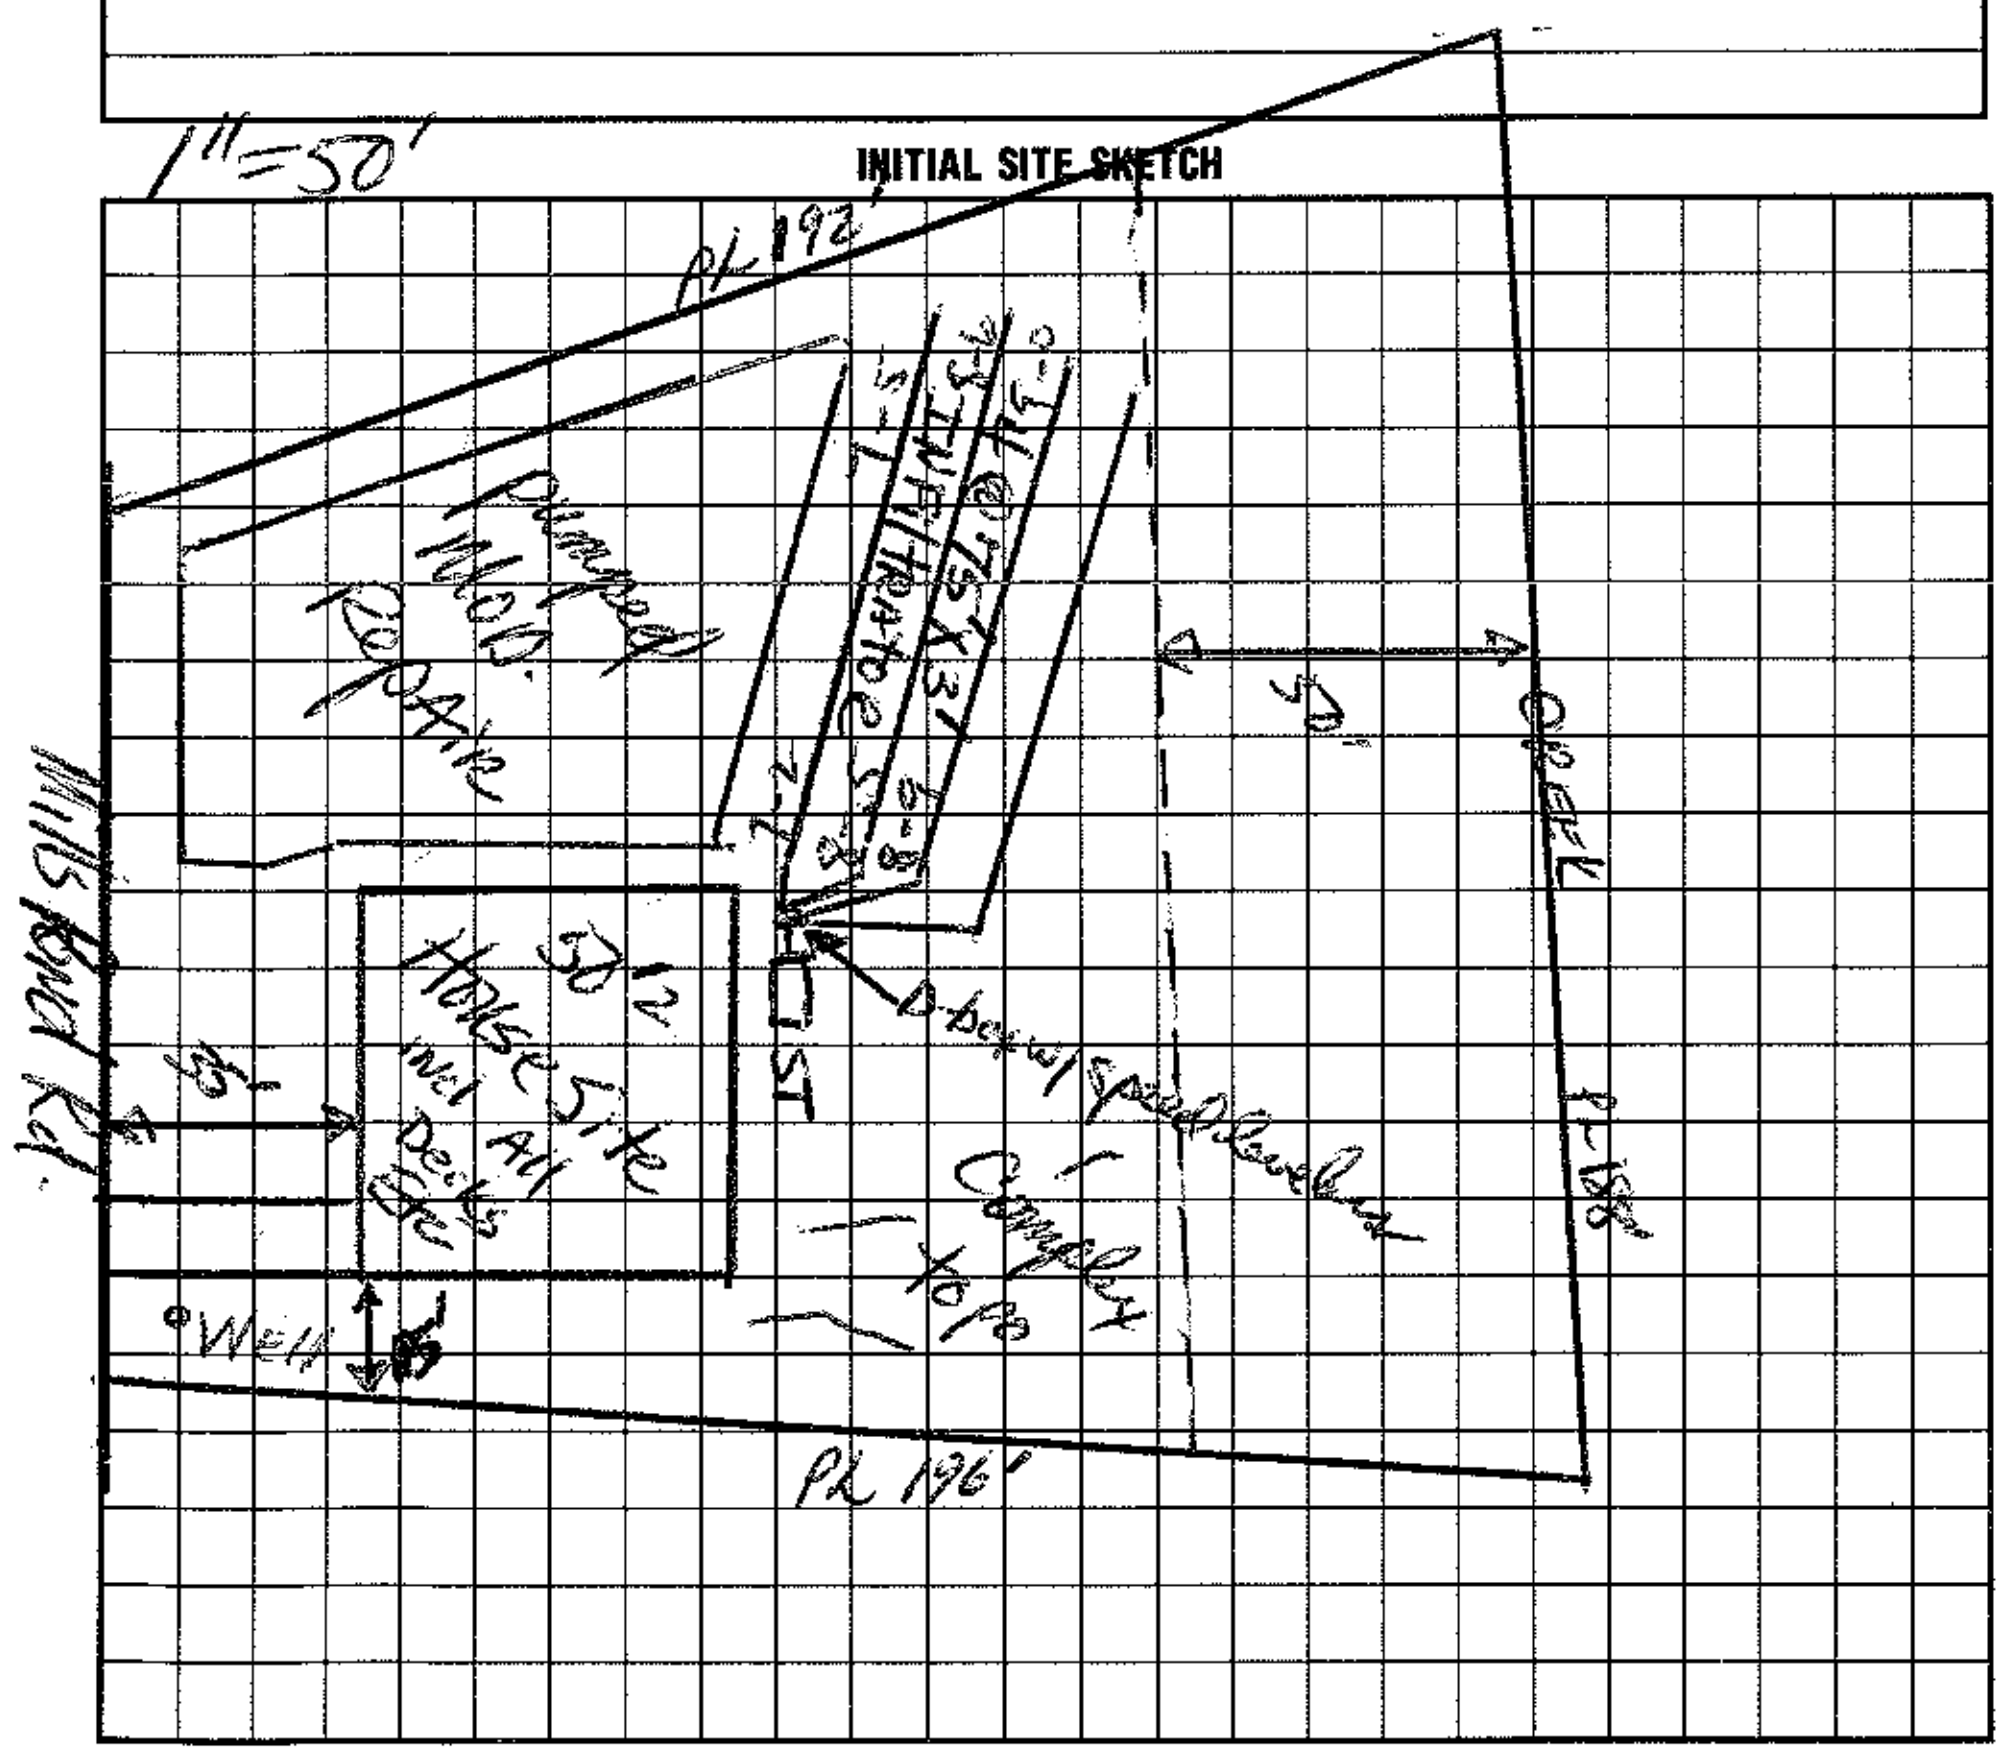

AS BUILT SKETCH

I understand that this permit can be suspended or revoked if any false information is supplied toward securing the permit/any unauthorized changes are made to the site/any unauthorized changes are made in the installation of the system. Improvement Permit is valid for 60 months from date of issuance.

Signed: X [signature] 6/15/95 Installed by: Rowan Septic Tank

Improvement Permit by: [signature] RS AWS date 3/31/95 Certificate of Completion by: [signature] R.S. date 9/6/95

Existing System Inspection by: ______ date ______ Operation Permit by: ______ date ______

HEALTH DEPT. COPY: WHITE INSPECTION COPY (FINAL): GREEN OWNER COPY (FINAL): YELLOW INSPECTION COPY (INITIAL): PINK OWNER COPY (INITIAL): GOLD