IREDELL COUNTY HEALTH DEPARTMENT

COUNTER

STATESVILLE 704-878-5305 MOORESVILLE 704-664-5281

IMPROVEMENT PERMIT / CERTIFICATE OF COMPLETION / OPERATION PERMIT / EXISTING SYSTEM INSPECTION

PROPERTY DESCRIPTION NO. 2055 DATE April 23, '95 TAX MAP NO. part of 2SA57 4638 98 3747 Watershed: ☑ Yes ☐ No

OWNER OR CONTRACTOR from Financial Services PHONE: Business 664-3671 Home

ADDRESS 19 Yacht Cove Rd. Mooresville LOCATION Potts Rd. to TR Cornelius Rd. TR Creek View Lane 8th Lot on Right

SUBDIVISION Mills Pond BLOCK / SECTION 2 LOT 39 LOT AREA .73 AC SITE CLASS. PS on 156 DESIGN FLOW 360 gpd L.T.A.R. .3

Septic Tank: 1000 Gallons; STB 925 Date 11/11/96

Pump Tank: 1000 Gallons; PT 47 Date 11/26/96

Pump Make: ZOELLER Model N131 Serial No.

Nitrification Field: No Fields 1 Square Feet 1200 Linear Feet 400

No Lines 4 Trench Width 36" Max Trench Bottom Depth 36" Gravel Depth 12"

☑ New System ☐ Repair System Type: I, II, III, IV, V, VI

System Description: pump/pm/conventional

Repair System Description: pump/pm/Infiltrator

Maintenance Agreement Required: ☐ Yes ☐ No

☑ House/Mod. Home No. Bedrooms 3

☐ Mobile Home No. Bathrooms 2

☐ Business No. Employees

☐ Other

☐ Slab ☑ Crawl Space ☐ Basement w/plumbing ☐ Basement wo/plumbing


Water Supply: ☑ Individual ☐ Community ☐ Public

Comments:

Comments: DEV[redacted] AWS 9/23/95 PER[redacted]

1"=50'

INITIAL SITE SKETCH

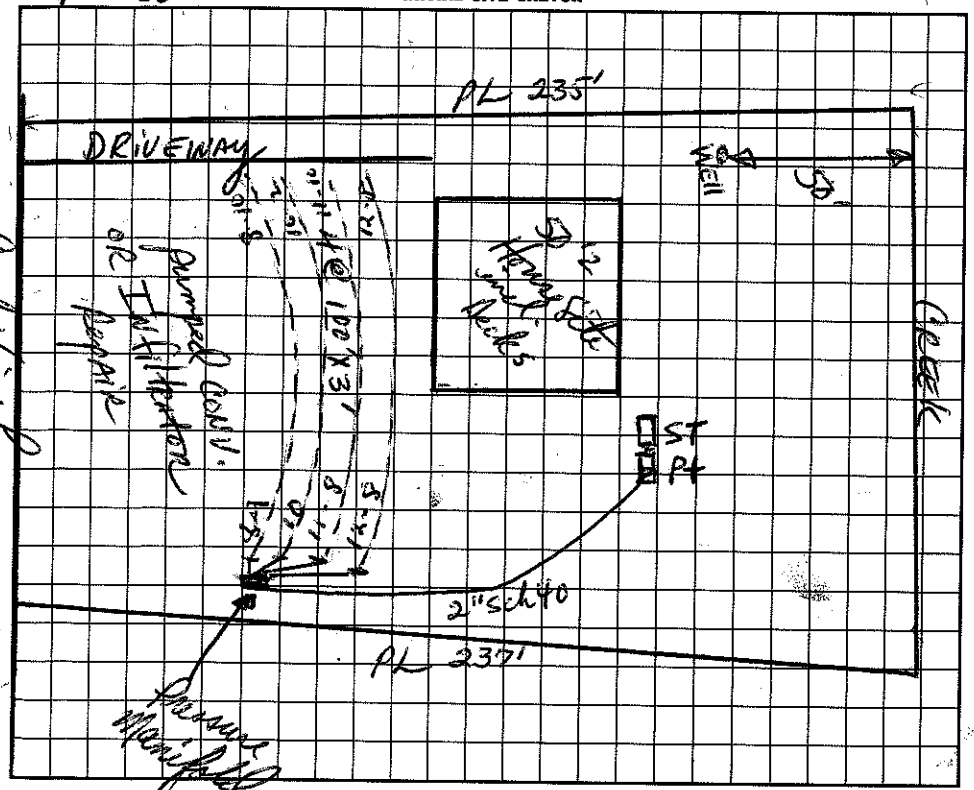

AS BUILT SKETCH

I understand that this permit can be suspended or revoked if any false information is supplied toward securing the permit/any unauthorized changes are made to the site/any unauthorized changes are made in the installation of the system. Improvement Permit is valid for 60 months from date of issuance.

Signed: Wesley Sparks 9/23/95

Improvement Permit by: Marvin Hoffman, RS date 4/23/95

Existing System Inspection by: date

Installed by: Rowan Septic Tank

Certificate of Completion by: date

Operation Permit by: Wesley Sparks RS. date 1/14/97

HEALTH DEPT. COPY: WHITE INSPECTION COPY (FINAL): GREEN OWNER COPY (FINAL): YELLOW INSPECTION COPY (INITIAL): PINK OWNER COPY (INITIAL): GOLD