IREDELL COUNTY HEALTH DEPARTMENT

STATESVILLE 704-878-5305 MOORESVILLE 704-664-5281

IMPROVEMENT PERMIT / CERTIFICATE OF COMPLETION / OPERATION PERMIT / EXISTING SYSTEM INSPECTION

PROPERTY DESCRIPTION NO. 20129 DATE March 29, '95 TAX MAP NO. part of 2545 1 Watershed: ☑ Yes ☐ No

OWNER OR CONTRACTOR Krom Financial Services PHONE: Business 664-3671 Home 4638-98-4015

ADDRESS 19 Yacht Cove Rd, Mooresville WSIV

LOCATION Faith Rd TR Cornelius Rd, TR Mills West Rd 5th lot on Right

SUBDIVISION Mills Pond West BLOCK / SECTION ____ LOT 14 LOT AREA .59ac SITE CLASS. PS DESIGN FLOW 360gpd L.T.A.R. .3

Septic Tank: 1000 Gallons; STB 825 Date 5/1/95 ☑ New System ☐ Repair System Type: I (II) III, IV, V, VI

Pump Tank: ____ Gallons; PT ____ Date ____ System Description: gravity conventional

Pump Make: ____ Model ____ Serial No. ____ Repair System Description: Same

Nitrification Field: No Fields 1 Square Feet 1200 Linear Feet 400 Maintenance Agreement Required: ☐ Yes ☑ No

No Lines 5 Trench Width 36" Max Trench Bottom Depth 36" Gravel Depth 12"

☑ House/Mod. Home No. Bedrooms 3 ☐ Slab ☑ Crawl Space ☐ Basement w/plumbing ☐ Basement wo/plumbing

☐ Mobile Home No. Bathrooms 2

☐ Business No. Employees ____

☐ Other ____


Water Supply: ☑ Individual ☐ Community ☐ Public

Comments: Exit plumbing at Ex grade where shown.

Comments: ~~DEVELOPER~~ Ready to observe ~~PERMIT~~ 5/23/95

1"=50'

INITIAL SITE SKETCH

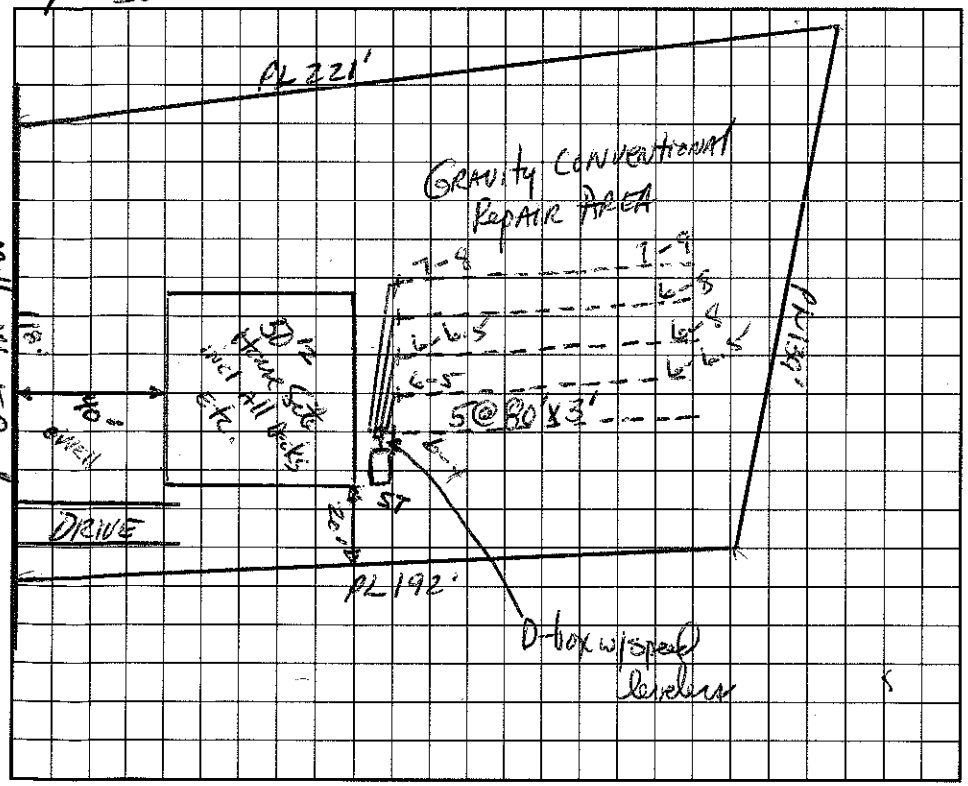

AS BUILT SKETCH

I understand that this permit can be suspended or revoked if any false information is supplied toward securing the permit/any unauthorized changes are made to the site/any unauthorized changes are made in the installation of the system. Improvement Permit is valid for 60 months from date of issuance.

Signed ____

Improvement Permit by: Mark R. Hinson, RS Wesley Sparks RS. date 3/29/95

Existing System Inspection by: ____ date ____

Installed by: Rowan Septic Tank

Certificate of Completion by: Wesley Sparks RS. date 9/20/95

Operation Permit by: ____ date ____

HEALTH DEPT. COPY: WHITE INSPECTION COPY (FINAL): GREEN OWNER COPY (FINAL): YELLOW INSPECTION COPY (INITIAL): PINK OWNER COPY (INITIAL): GOLD