IREDELL COUNTY HEALTH DEPARTMENT

STATESVILLE 704-878-5305 MOORESVILLE 704-664-5281

IMPROVEMENT PERMIT / CERTIFICATE OF COMPLETION / OPERATION PERMIT / EXISTING SYSTEM INSPECTION

PROPERTY DESCRIPTION NO. 20139 DATE March 31, 195 TAX MAP NO. part of 7845-51 Watershed: ☑ Yes ☐ No

OWNER OR CONTRACTOR Lyon Financial Services PHONE: Business 664-3671 Home 4638-98-4430

ADDRESS 19 Gaskill Court Mooresville

LOCATION Gaskill Rd. TO Cornelius Rd TO Mills Pond Rd. 4th lot on left

SUBDIVISION Mills Pond BLOCK / SECTION ____ LOT 24 LOT AREA .61Ac SITE CLASS. Bpn956 DESIGN FLOW 360gpd L.T.A.R. .3

Septic Tank: 1000 Gallons; STB 825 Date 5/19/95

Pump Tank: ____ Gallons; PT ____ Date ____

Pump Make: ____ Model ____ Serial No. ____

Nitrification Field: No Fields 1 Square Feet 900 Linear Feet 300

No Lines 3 Trench Width 36" Max Trench Bottom Depth 36" Gravel Depth N/A

☐ New System ☐ Repair System Type: I, II, (III) IV, V, VI

System Description: gravity Infiltrator

Repair System Description: gravity/pumped INF

Maintenance Agreement Required: ☐ Yes ☑ No

☑ House/Mod. Home No. Bedrooms 3

☐ Mobile Home No. Bathrooms 2

☐ Business No. Employees ____

☐ Other ____


☐ Slab ☑ Crawl Space ☐ Basement w/plumbing ☐ Basement wo/plumbing

Water Supply: ☑ Individual ☐ Community ☐ Public

Comments:

Comments: [redacted]

INITIAL SITE SKETCH

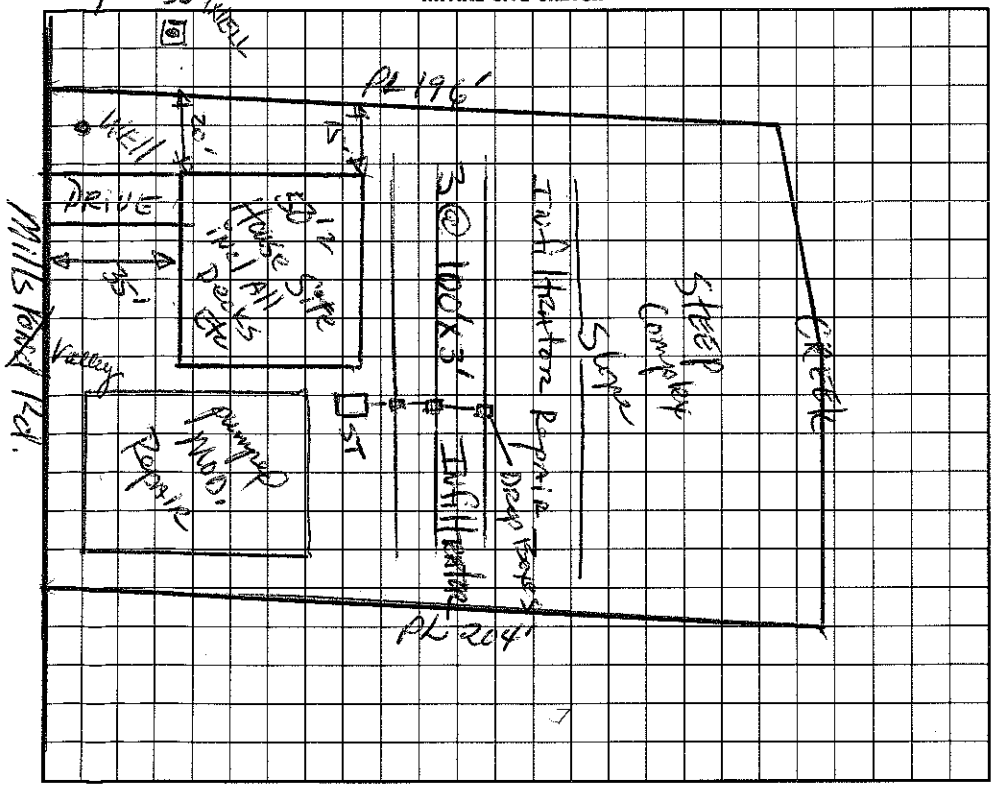

AS BUILT SKETCH

I understand that this permit can be suspended or revoked if any false information is supplied toward securing the permit/any unauthorized changes are made to the site/any unauthorized changes are made in the installation of the system. Improvement Permit is valid for 60 months from date of issuance.

Signed: [signature]

Improvement Permit by: Wesley Sparks RS. 9/19/95 date 3/31/95

Existing System Inspection by: Wesley Sparks RS date 5/19/95

Installed by: Rowan Septic Tank

Certificate of Completion by: ____ date ____

Operation Permit by: Wesley Sparks RS. date 6/14/95

HEALTH DEPT. COPY: WHITE INSPECTION COPY (FINAL): GREEN OWNER COPY (FINAL): YELLOW INSPECTION COPY (INITIAL): PINK OWNER COPY (INITIAL): GOLD