4638 98 4638

IREDELL COUNTY HEALTH DEPARTMENT

STATESVILLE 704-878-5305 MOORESVILLE 704-664-5281

IMPROVEMENT PERMIT / CERTIFICATE OF COMPLETION / OPERATION PERMIT / EXISTING SYSTEM INSPECTION

PROPERTY DESCRIPTION NO. 20552 DATE April 23 '95 TAX MAP NO. part of 25A57 Watershed: ☑ Yes ☐ No

OWNER OR CONTRACTOR Ivan Financial Services PHONE: Business 664 3671 Home

ADDRESS 19 Yacht Cove Rd. Mooresville (190 Creek View Home) WSIC

LOCATION South Rd. N. TR Cornelius Rd. TR Creek View Lane 9th lot on Right

SUBDIVISION Mills Pond BLOCK / SECTION LOT 40 LOT AREA .67AC SITE CLASS V on 1956 DESIGN FLOW 360gpd L.T.A.R. .3

Septic Tank: 1000 Gallons; STB 794 Date 4/24/00
Pump Tank: 1800 Gallons; PT 27 Date 4/22/00
Pump Make: GOULDS Model WE0-511H Serial No. D003452 8
Nitrification Field: No Fields 1 Square Feet 900 Linear Feet 300
No Lines 3 @ Trench Width 36" Max Trench Bottom Depth 36" Gravel Depth NA

☑ New System ☐ Repair System Type: I, II, III, IV, V, VI
System Description: pump/fm/INFILTRATOR
Repair System Description: same
Maintenance Agreement Required: ☐ Yes ☑ No

☑ House/Mod. Home No. Bedrooms 3
☐ Mobile Home No. Bathrooms 2
☐ Business No. Employees
☐ Other
☐ Slab ☑ Crawl Space ☐ Basement w/plumbing ☐ Basement wo/plumbing


Water Supply: ☑ Individual ☐ Community ☐ Public

Comments:


Comments: DEVELOPER TO PERMIT Type 4 PPBPS Drainfield Installed

1"=50'

INITIAL SITE SKETCH

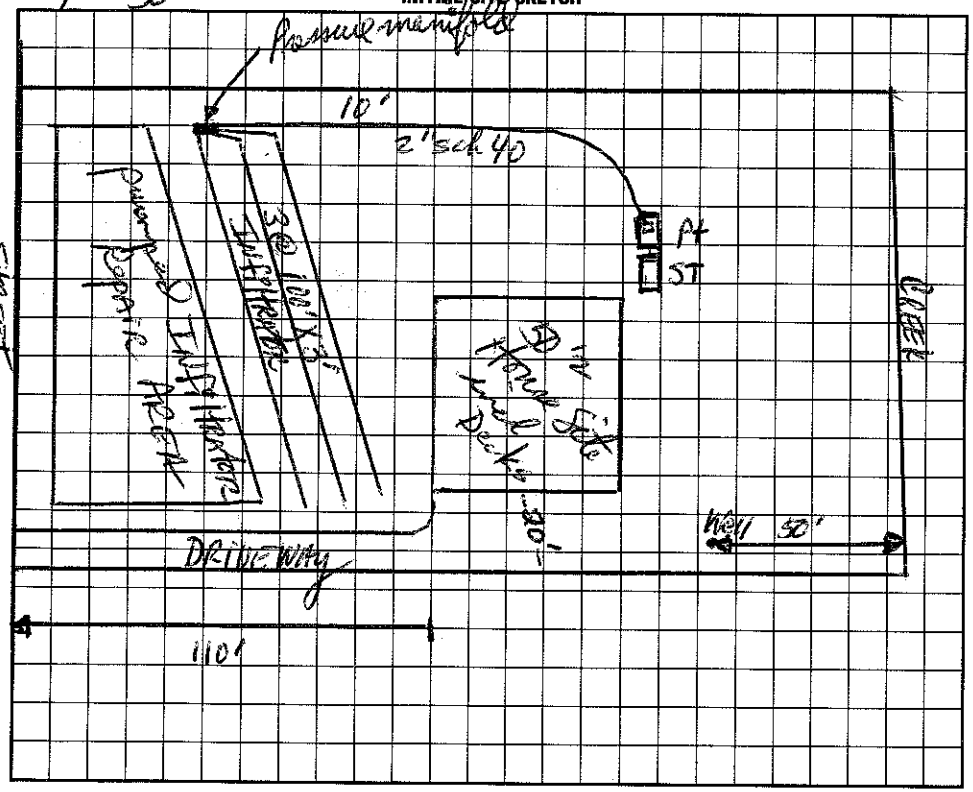

AS BUILT SKETCH

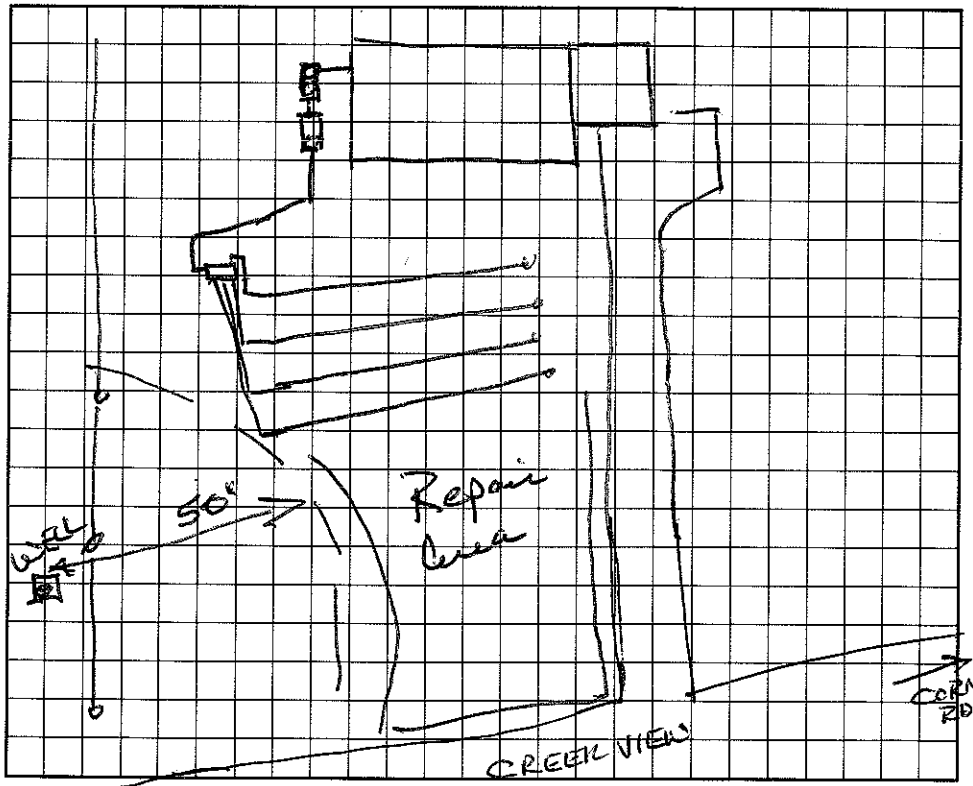

I understand that this permit can be suspended or revoked if any false information is supplied toward securing the permit/any unauthorized changes are made to the site/any unauthorized changes are made in the installation of the system. Improvement Permit is valid for 60 months from date of issuance.

Signed: Wesley Sparks 9/23/95

Improvement Permit by: RS date 4/23/95

Existing System Inspection by: date

Installed by: F I Ervin

Certificate of Completion by: RS date 7/19/00

Operation Permit by: Wesley Sparks RS. date 2/14/01

HEALTH DEPT. COPY: WHITE INSPECTION COPY (FINAL): GREEN OWNER COPY (FINAL): YELLOW INSPECTION COPY (INITIAL): PINK OWNER COPY (INITIAL): GOLD